

Registration Statement

OF CLAIMANT OF RIGHT TO APPROPRIATE GROUND WATER

TO THE STATE ENGINEER OF OREGON:

I, Philip V. Bunningof Gervais, Oregon County of MarionState of Oregon, do hereby make application for a certificate of registration as evidence of a right to appropriate ground water.1. Source from which water is withdrawn is Well

(Flowing well, pump well, infiltration trench, or tunnel)

2. Location is: 1 mile from Gervais, north

(Approximate distance and direction from nearest city or town)

and is more particularly described as follows:

(a) 5 ch. S & 4 ch. E from NW corner SE 1/4 NW 1/4 Section 25

(Give distance and bearing to corner of section or other legal subdivision)

being within SE 1/4 NW 1/4 of Sec. 25, Twp. 5, Rge. 2W

(Smallest legal subdivision)

(N. or S.)

(E. or W.)

or (b) within limits of recorded platted property, town or city:

in Lot _____, Block _____ of _____

(Name of plat or addition)

(If within city or town, give name) _____ County of _____

3. Construction Work was begun on March 20, 1952, was completed on April 10, 1952

(Date)

(Date)

and the ground water claimed was first used for the purposes set out below on April 20, 1952

(Date)

since which time the water has been used intermittently Continuously

(Continuously or Intermittently)

from May to Oct each year

(Date)

(Date)

4. Quantity of water claimed and used is 150 gallons per minute; 96 acre feet per year.5. Purpose or Purposes for which water is used irrigation & domestic

(Domestic, irrigation, municipal, manufacturing, industrial, etc.)

6. Description of Well: Depth 143 feet. Type drilled

(Dug or drilled)

diameter 10 inches. Elevation of ground at well site _____ feet, mean sea level.

(As near as known)

Depth to water table 13 1/2 feet.7. Capacity of Well: 140 g.p.m. with 28 feet drawdown.400 g.p.m. with 73 feet drawdown.Date of test April 10, 1952

If Flowing Well: Measured discharge _____ g.p.m. on _____

(Date)

Shut-in pressure at ground surface _____ lbs. per sq. in. on _____

(Date)

Water is controlled by _____

(Cap, valve, etc.)

size.)

10 inch diameter steel from top to bottom feet

..... inch diameter..... from..... to..... feet

..... inch diameter from to feet

..... inch diameter from to feet

Describe and show depth of shoe, plug, adapter, liner or other details: _____

9. Perforated Casings or Screens:

Miller perforated Sterling from 100 to 130 up

..... from to

..... from to

..... from to

10. Log of Well: (Describe each stratum or formation clearly, indicate if water bearing, and give thickness and depth as indicated.)

[illegible]

.....

11. Infiltration Trench: Covered or open

Dimensions: Length ft. Minimum depth ft. Maximum depth ft.

Bottom width ft. Discharge g.p.m. Date of test

12. Tunnel: Type of lining

Dimensions: (Length, column and cross sectional size)

(Length, course, and cross sectional size)

Position of water bearing stratum with reference to portal of tunnel

Log of tunnel: (Preceding table for log of well may be used, if desired. Give footage from portal and character of materials, as pertinent.)

13. Pumping Equipment:

(a) Pump Vacuum Turbine Capacity 50 g.p.m.

(b) Motor 5hp ~~3hp~~ Pacific 1 phase, 240 volt
(Type and horsepower)


14. Location of area irrigated or to be irrigated, or place of use if for purposes other than irrigation.

[illegible]

15. If the ground water supply is supplemental to an existing water supply, identification of any application for a permit, permit, certificate or adjudicated right to appropriate water made or held by the registrant.

None

Township 55 Range 2W W.M.
North

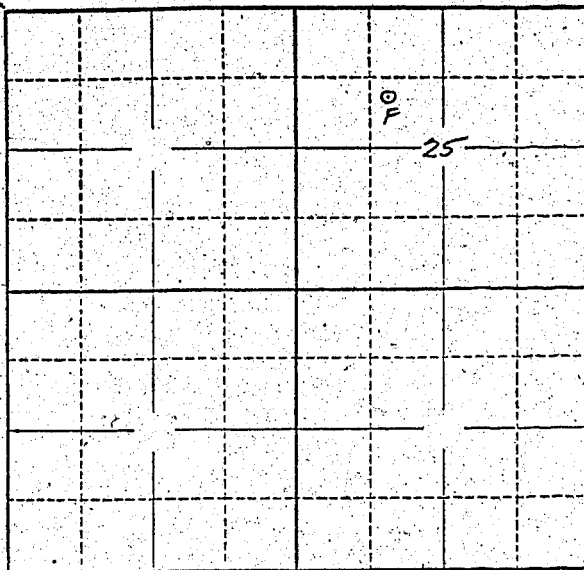

Locate well and acreage of irrigated land on plat.
Scale: 2" = 1 Mile

STATE OF OREGON

County of Marion

} ss.

I, Philip V. Berning, being first duly sworn, do hereby certify that I have read the foregoing Registration Statement and that all of the items therein contained are true to the best of my knowledge and belief.

Philip V. Berning
(Signature of Registrant)

Subscribed and sworn to before me this 21st day of July, 1958.

My commission expires Sept. 8, 1960

Chris E. Miller
(Notary Public)

(SEAL)

CERTIFICATE OF REGISTRATION

STATE OF OREGON

County of Marion

} ss.

This is to certify that the foregoing Registration Statement was received in the office of the State Engineer on the 21st day of July, 1958, at 9⁰⁰ o'clock A M. and has been duly recorded in said office in Book No. 10 of Registration Statements on page GR-2236

Witness my hand this 10th day of March, 1959

Laura A. Stanley
(State Engineer)

By

(Deputy)

\$17.85

GR - 2236