

# Registration Statement

## OF CLAIMANT OF RIGHT TO APPROPRIATE GROUND WATER

TO THE STATE ENGINEER OF OREGON:

I, Sister Dolores Mary

of Marylhurst County of Clackamas  
(Mailing address)

State of Oregon, do hereby make application for a certificate of registration as evidence of a right to appropriate ground water.

1. Source from which water is withdrawn is pump well # 2  
(Flowing well, pump well, infiltration trench, or tunnel)

2. Location is: 1 mile south of Oswego  
(Approximate distance and direction from nearest city or town)

and is more particularly described as follows:

(a) 1,397.4 feet, S. 01° 31' E., to 1/4 Corner common to Sections 11 & 14  
(Give distance and bearing to corner of section or other legal subdivision)

being within SW 1/4 of NE 1/4 of Sec. 14, Twp. 2 S., Rge. 1 E.  
(Smallest legal subdivision) (N. or S.) (E. or W.)

or (b) within limits of recorded platted property, town or city:

in Lot \_\_\_\_\_, Block \_\_\_\_\_ of \_\_\_\_\_  
(Name of plat or addition)

\_\_\_\_\_ County of \_\_\_\_\_  
(If within city or town, give name)

3. Construction Work was begun on April 14, 1947; was completed on June 17, 1947  
(Date) (Date)

and the ground water claimed was first used for the purposes set out below on September 1947  
(Date)

since which time the water has been used continuously  
(Continuously or intermittently)

from September 1947 to July 1958  
(Date) (Date)

4. Quantity of water claimed and used is 95 gallons per minute; 127 acre feet per year.

5. Purpose or Purposes for which water is used domestic and irrigation

(Domestic, irrigation, municipal, manufacturing, industrial, etc.)

6. Description of Well: Depth 519 feet. Type dug  
(Dug or drilled)

diameter 12 inches. Elevation of ground at well site 156 feet, mean sea level.  
(As near as known)

Depth to water table 27 1/2 feet.

7. Capacity of Well: 95 g.p.m. with 153 feet drawdown.

\_\_\_\_\_ g.p.m. with \_\_\_\_\_ feet drawdown.

Date of test July 9, 1958

September 1947: 300 g.p.m. with 80 feet drawdown.

If Flowing Well: Measured discharge \_\_\_\_\_ g.p.m. on \_\_\_\_\_  
(Date)

Shut-in pressure at ground surface \_\_\_\_\_ lbs. per sq. in. on \_\_\_\_\_  
(Date)

Water is controlled by \_\_\_\_\_  
(Cap, valve, etc.)

8. Casing: (Give diameter, commercial specifications and depth below ground surface of each casing size.)

12 inch diameter steel pipe from surface to 81 feet  
 inch diameter from to feet  
 inch diameter from to feet  
 inch diameter from to feet

Describe and show depth of shoe, plug, adapter, liner or other details: air line in shaft

9. Perforated Casings or Screens:

(Number per foot and size of perforations, or describe screen) from to  
 from to  
 from to  
 from to

10. Log of Well: (Describe each stratum or formation clearly, indicate if water bearing, and give thickness and depth as indicated.)

MATERIAL	Thickness (Feet)	Depth to Bottom (Feet)
Clay	5	5
Brown sand	13	18
Sand and gravel	17	35
Soft red rock	14	49
Cemented gravel	15	64
Brown, medium hard rock	17	81
Gray hard rock	80	161
Seams in the rock	2	163
Hard gray rock	11	174
Brown rock	7	181
Hard gray rock	12	193
Black, medium hard rock	16	209
Gray rock	4	213
Gray, medium hard rock	41	254
Porous red and gray rock with water	12	266
Brown rock	27	293
Mixture of green, brown and black rock	8	301
Gray hard rock	50	351
Hard brown rock	18	369
Hard gray rock	41	410
Hard black rock	12	422
Hard gray rock	25	447
Porous black rock with water	9	456
Gray hard rock	20	476
Hard black rock	25	501
Broken formation with water	11	512
Gray hard rock	7	519

If log of well is not available, give name and address of driller. ....

11. Infiltration Trench: Covered or open .....

Dimensions: Length ..... ft. Minimum depth ..... ft. Maximum depth ..... ft.

Bottom width ..... ft. Discharge ..... g.p.m. Date of test .....

12. Tunnel: Type of lining .....

Dimensions: .....  
(Length, course, and cross sectional size) .....

Position of water bearing stratum with reference to portal of tunnel .....

Log of tunnel: (Preceding table for log of well may be used, if desired. Give footage from portal and character of materials, as pertinent.)

13. Pumping Equipment:

(a) Pump Peerless ..... Capacity 350 ..... g.p.m.  
(Make, type and size)

(b) Motor Westinghouse 30 hp .....  
(Type and horsepower)


14. Location of area irrigated or to be irrigated, or place of use if for purposes other than irrigation.

Township North or South	Range E. or W. of Willamette Meridian	Section	Forty-acre Tract	Number Acres To Be Irrigated	Date of Reclamation
2 S	1 E	14	SW $\frac{1}{4}$ of NE $\frac{1}{4}$	Domestic: College 8 Buildings including Heating Plant and Swimming pool. Irrigation: 4 acres including cemetery.	September 1947
2 S	1 E	14	NW $\frac{1}{4}$ of NE $\frac{1}{4}$	Domestic: Convent, Rosecliff Hall, Sewage treatment plant. Irrigation: 9 acres.	September 1947
2 S	1 E	14	NE $\frac{1}{4}$ of NW $\frac{1}{4}$	Domestic: Christie School, Laundry, Heating Plant, Men's Lodge, Chaplain's Residence, Farm Cottage, Swimming pool, Cattle barn. Irrigation: 7 acres.	September 1947
2 S	1 E	14	SE $\frac{1}{4}$ of NW $\frac{1}{4}$	Irrigation: 5 acres	September 1947

15. If the ground water supply is supplemental to an existing water supply, identification of any application for a permit, permit, certificate or adjudicated right to appropriate water made or held by the registrant.

Township 2 S. Range 1 E., W.M.

North 1/4 SEC. COR. 11814 S. 01° 03' E. 1397.4'

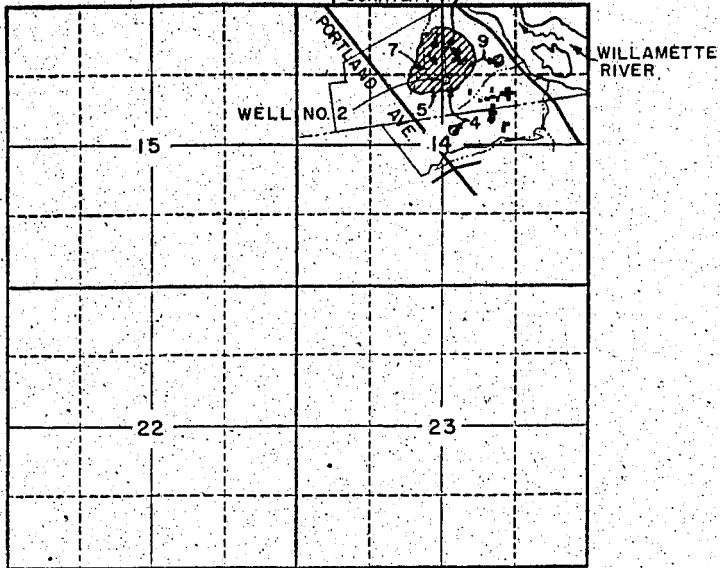

Locate well and acreage of irrigated land on plat.

Scale: 2" = 1 Mile

STATE OF OREGON

County of Clackamas } ss.

I, Sister Dolores Mary, being first duly sworn, do hereby certify that I have read the foregoing Registration Statement and that all of the items therein contained are true to the best of my knowledge and belief.

*Sister Dolores Mary*  
(Signature of Registrant)

Subscribed and sworn to before me this 19th day of July, 1958.

My commission expires February 7, 1959 E. M. Atkinson  
(Notary Public)

(SEAL)

**CERTIFICATE OF REGISTRATION**

STATE OF OREGON } ss.  
County of Marion

This is to certify that the foregoing Registration Statement was received in the office of the State Engineer on the 21 day of July, 1958, at 8:00 o'clock A. M. and has been duly recorded in said office in Book No. 10 of Registration Statements on page GR 2239

Witness my hand this 10th day of March, 1959

*Laura A. Stanley*  
(State Engineer)

By \_\_\_\_\_ (Deputy)

# 2500

GR-2239