

# Registration Statement

## OF CLAIMANT OF RIGHT TO APPROPRIATE GROUND WATER

TO THE STATE ENGINEER OF OREGON:

I, Darrel Carter

of P.O. Box 155, Riddle, Ore. County of Douglas

State of Oregon, do hereby make application for a certificate of registration as evidence of a right to appropriate ground water.

1. Source from which water is withdrawn is Pump Well  
(Flowing well, pump well, infiltration trench, or tunnel)

2. Location is: 1/2 Mile S.E. City of Riddle  
(Approximate distance and direction from nearest city or town)

and is more particularly described as follows: Beginning at a pipe from which the S.E. Corner of the J.C.C. Vanderbosch D.L.C. No. 47 in T. 30 S - R6W, W.M., Douglas County, Ore. bears  
(a) N 21° 41' E 2128.0 ft., thence N 71° 56' E 696 ft. to Well  
(Give distance and bearing to corner of section or other legal subdivision)

being within SE 1/4 of SW 1/4 of Sec. 24, Twp. 30, Rge. 6W  
(Smallest legal subdivision) (N. or S.) (E. or W.)

or (b) within limits of recorded platted property, town or city:

in Lot \_\_\_\_\_, Block \_\_\_\_\_ of \_\_\_\_\_  
(Name of plat or addition)

County of \_\_\_\_\_  
(If within city or town, give name)

3. Construction Work was begun on Aug. 1943; was completed on Aug. 1943  
(Date) (Date)

and the ground water claimed was first used for the purposes set out below on Aug. 1943,  
(Date) Continuously for domestic and stock, depending on need since which time the water has been used for irrigation, part irrigated every year.  
(Continuously or intermittently)

from May to Oct.  
(Date) (Date)

4. Quantity of water claimed and used is up to 80 gallons per minute; \_\_\_\_\_ acre feet per year.

5. Purpose or Purposes for which water is used Domestic (house, lawn and garden)  
(Domestic, irrigation, municipal, manufacturing, industrial, etc.)

Irrigation of Pear orchard 1 acre; Pasture or clover 3 to 5 acres

6. Description of Well: Depth 12 feet. Type Dug  
(Dug or drilled)  
2' x 2' x 5' base 8" tile

diameter to top \_\_\_\_\_ inches. Elevation of ground at well site 700 feet, mean sea level.  
(As near as known)

Depth to water table 9 feet in Aug. 1943

7. Capacity of Well: 80 g.p.m. with unknown feet drawdown.  
120 approx g.p.m. with 2 ft feet drawdown. in Aug. 1943

Date of test Aug. 1943

If Flowing Well: Measured discharge \_\_\_\_\_ g.p.m. on \_\_\_\_\_  
(Date)


Shut-in pressure at ground surface \_\_\_\_\_ lbs. per sq. in. on \_\_\_\_\_  
(Date)

Water is controlled by \_\_\_\_\_  
(Cap. valve, etc.)





Township 30 Range 6 W. W.M.  
North

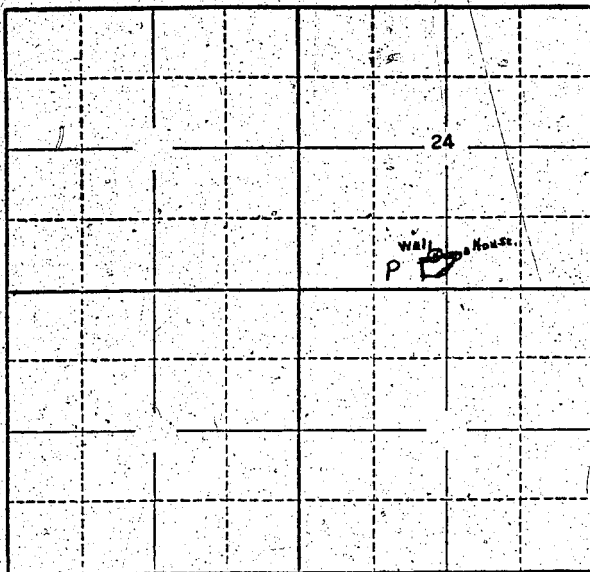

Locate well and acreage of irrigated land on plat.  
Scale: 2" = 1 Mile

STATE OF OREGON

County of Douglas

} ss.

I, Darrel Carter, being first duly sworn, do hereby certify that I have read the foregoing Registration Statement and that all of the items therein contained are true to the best of my knowledge and belief.

Darrel Carter  
(Signature of Registrant)

Subscribed and sworn to before me this 17<sup>th</sup> day of JULY, 1958

My commission expires MAY 10, 1960

W. W. Seaberg  
(Notary Public)

(SEAL)

**CERTIFICATE OF REGISTRATION**

STATE OF OREGON

County of Douglas

} ss.

This is to certify that the foregoing Registration Statement was received in the office of the State Engineer on the 21<sup>st</sup> day of July, 1958, at 8:00 o'clock A. M. and has been duly recorded in said office in Book No. 10 of Registration Statements on page GR-221

Witness my hand this 10<sup>th</sup> day of March, 1959

Henry A. Kistner  
(State Engineer)

\$15.00

By \_\_\_\_\_ (Deputy)

GR-221