

RECEIVED
APR 7 1958
STATE ENGINEER
SALEM, OREGON

REGISTRATION NO. GR-2365
CERTIFICATE NO. GR-2246

Registration Statement

OF CLAIMANT OF RIGHT TO APPROPRIATE GROUND WATER

(Under Chapter 708, Oregon Laws 1955.)

TO THE STATE ENGINEER OF OREGON:

I, Robert J. Williams
of Route 2, Box 252 Canby County of Clatsop
State of Oregon, do hereby make application for a certificate of registration as evidence
of a right to appropriate ground water.

1. Source from which water is withdrawn is Pump well
(Flowing well, pump well, infiltration trench, or tunnel)

2. Location is: 5 mi. South of Canby on Canby, Garoussi Highway
(Approximate distance and direction from nearest city or town)

and is more particularly described as follows:

(a) _____
(Give distance and bearing to corner of section or other legal subdivision)

being within S.W. 1/4 of S.W. 1/4 of Sec. _____ Twp. _____ Rge. _____
(Smallest legal subdivision) (N. or S.) (E. or W.)

or (b) within limits of recorded platted property, town or city:

in Lot _____ Block _____ of _____
(Name of plat or addition)

County of _____
(If within city or town, give name)

3. Construction Work was begun on 8/4/51; was completed on 8/10/51
(Date) (Date)

and the ground water claimed was first used for the purposes set out below on 1951
since which time the water has been used continuously (continuously) Irrigation (seasonal)
(Continuously or intermittently)

from 9/11/51 to Present
(Date) (Date)

4. Quantity of water claimed and used is 17 gallons per minute; 41 acre
feet per year.

5. Purpose or Purposes for which water is used irrigation
(Domestic, irrigation, municipal, manufacturing, industrial, etc.)

6. Description of Well: Depth 300 feet. Type Drilled
(Dug or drilled)
diameter 8" inches. Elevation of ground at well site 178 feet, mean sea level.
(As near as known)

Depth to water table 6 feet.

7. Capacity of Well: 100 g.p.m. with 99 feet drawdown.
100 g.p.m. with 100 feet drawdown.

Date of test 8/10/51

If Flowing Well: Measured discharge _____ g.p.m. on _____ (Date)

* Shut-in pressure at ground surface _____ lbs. per sq. in. on _____ (Date)

Water is controlled by _____
(Cap, valve, etc.)

8. Casings: (Give diameter, commercial specifications and depth below ground surface of each casing size.)

8 inch diameter from 0 to 230 feet
 inch diameter from to feet
 inch diameter from to feet
 inch diameter from to feet

Describe and show depth of shoe, plug, adapter, liner or other details: The bottom of the pipe contains a standard 8" harden shoe.

9. Perforated Casings or Screens:

Perforations 80 slots 1" X 3/8 from 75 to 80
(Number per foot and size of perforations, or describe screen)
 80 slots " " from 135 to 140
 440 slots " " from 160 to 215
 Star perforator was used. from to

10. Leg of Well: (Describe each stratum or formation clearly, indicate if water bearing, and give thickness and depth as indicated.)

MATERIAL	Thickness (Feet)	Depth to Bottom (Feet)
Brown silt	55	55
blue silt	22	77
Cement Gravel (blue clay binder) small amount of water	75	80
Blue clay (light and dark streaks)	60	140
Dark sand medium grit. (Packed rather hard did not ruff)	150	140
Very dark blue clay (turns to black)	140	154
Dark sand with clay binder (some water did not cave) <small>stove here and to the well water from above stratum produced 40 G. ...</small>	154	198
Blue clay with brown streaks in it	198	250
very dark blue clay changing to black at bottom of layer	250	255
and dark sh. fine	255	272
Course sand (main water flow)	270	277
light blue clay	287	300
Welling below 277 ft. an exploratory tubing to find a gravel stratum to take water		

If log of well is not available, give name and address of driller _____

11. Infiltration Trench: Covered or open _____

Dimensions: Length _____ ft. Minimum depth _____ ft. Maximum depth _____ ft.

Bottom width _____ ft. Discharge _____ g.p.m. Date of test _____

12. Tunnel: Type of lining _____

Dimensions: _____
(Length, course, and cross sectional size)

Position of water bearing stratum with reference to portal of tunnel _____

Log of tunnel: (Preceding table for log of well may be used, if desired. Give footage from portal and character of materials, as pertinent.)

13. Pumping Equipment:

(a) Pump Cook - Rotation _____ Capacity 200 g.p.m.
(Make, type and size)


(b) Motor General Electric 7.5 Single Phase _____
(Type and horsepower)

14. Location of area irrigated or to be irrigated, or place of use if for purposes other than irrigation.

Township North or South	Range E. or W. of Willamette Meridian	Section	Forty-acre Tract	Number Acres To Be Irrigated	Date of Reclamation
45	1E	22	SW 1/4 SW 1/4	20	1951
"	"	"	SE 1/4 SW 1/4	10	"
				<u>30</u>	

15. If the ground water supply is supplemental to an existing water supply, identification of any application for a permit, permit, certificate or adjudicated right to appropriate water made or held by the registrant.

Township 48 Range 1, W.M.
North

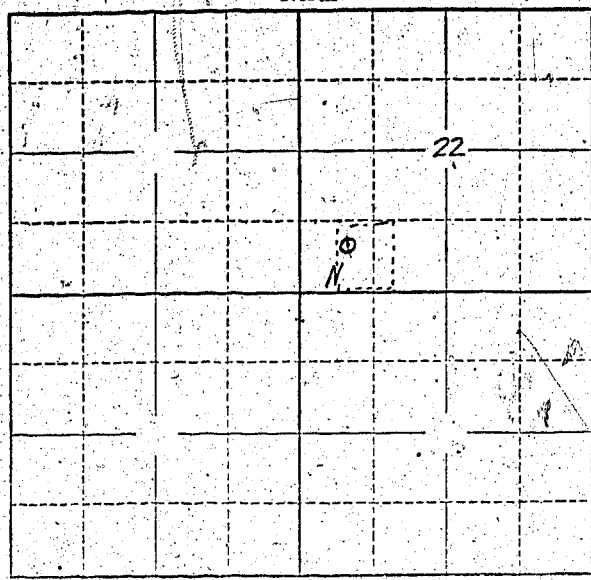

Locate well and acreage of irrigated land on plat.
Scale: 2" = 1 Mile

STATE OF OREGON }
County of Clackamas } ss.

I, Ben Nettmann, being first duly sworn, do hereby certify that I have read the foregoing Registration Statement and that all of the items therein contained are true to the best of my knowledge and belief.

[Signature]
(Signature of Registrant)

Subscribed and sworn to before me this 29 day of May, 1951

My commission expires July 22 - 1961

[Signature]
(Notary Public)

(SEAL)

CERTIFICATE OF REGISTRATION

STATE OF OREGON }
County of Marion } ss.

This is to certify that the foregoing Registration Statement was received in the office of the State Engineer on the 21st day of July, 1950, at 6:00 o'clock A.M. and has been duly recorded in said office in Book No. 10 of Registration Statements on page GR-2216

~~Construction of this completed by 19 and the same completed by 19~~
~~was closed by 19~~

Witness my hand this 10th day of March, 1959

.....
(State Engineer)

By
(Deputy)

\$15.00

GR-2216