

Registration Statement

OF CLAIMANT OF RIGHT TO APPROPRIATE GROUND WATER

TO THE STATE ENGINEER OF OREGON:

I, Gaylord N. Shipley and Mary E. Shipley

of 10005-2nd Ave. So. Seattle 88, County of King
(Mailing address)

State of Wash., do hereby make application for a certificate of registration as evidence of a right to appropriate ground water.

1. Source from which water is withdrawn is Pump Well
(Flowing well, pump well, infiltration trench, or tunnel)

2. Location is: 1 mile west and 2/10th mile north of Holland
(Approximate distance and direction from nearest city or town)

and is more particularly described as follows: The South 10 acres of the South 1/4 of the Northeast Quarter of the Northwest Quarter of Section 32, Township 39 South,
480ft South + 700ft West from N 1/4 corner Section 32.

(a) Range 7 West of the Willamette Meridian
(Give distance and bearing to corner of section or other legal subdivision)

being within NE 1/4 of NW 1/4 of Sec. 32, Twp. 39 South, Rge. 7 W
(Smallest legal subdivision) (N. or S.) (E. or W.)

or (b) within limits of recorded platted property, town or city: _____

in Lot _____, Block _____ of _____
(Name of plat or addition)

County of Josephine
(If within city or town, give name)

3. Construction Work was begun on 1944; was completed on 1944
(Date) (Date)

and the ground water claimed was first used for the purposes set out below on 1944
(Date)

since which time the water has been used continuously
(Continuously or intermittently)

from 1944 to 1957
(Date) (Date)

4. Quantity of water claimed and used is 10 gallons per minute; _____ acre feet per year.

5. Purpose or Purposes for which water is used irrigation and domestic

(Domestic, irrigation, municipal, manufacturing, industrial, etc.)

6. Description of Well: Depth 16 feet. Type Drilled
(Dug or drilled)

diameter _____ inches. Elevation of ground at well site 1505 feet, mean sea level.
(As near as known)

Depth to water table 7 feet.

7. Capacity of Well: 20 g.p.m. with 7 feet drawdown.

_____ g.p.m. with _____ feet drawdown.


Date of test: 1957

If Flowing Well: Measured discharge _____ g.p.m. on _____
(Date)

Shut-in pressure at ground surface _____ lbs. per sq. in. on _____
(Date)

Water is controlled by _____
(Cap, valve, etc.)

Township 39 S Range 7 W W.M.
North

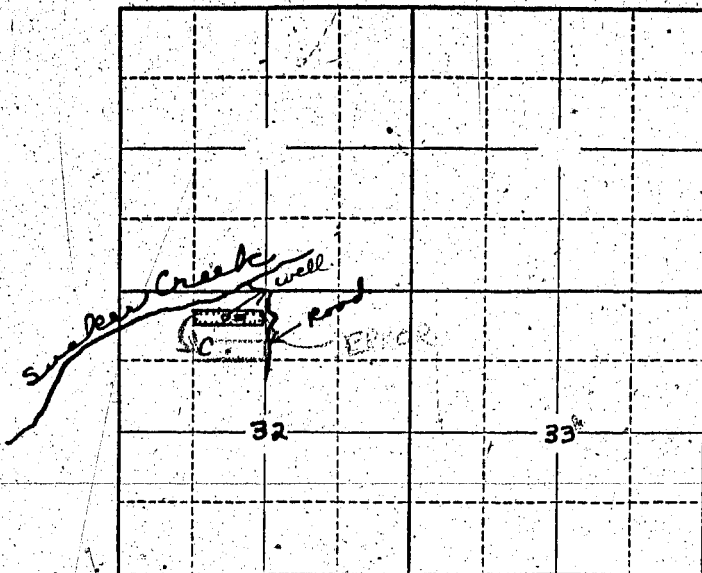

Locate well and acreage of irrigated land on plat.
Scale: 2" = 1 Mile

STATE OF OREGON

County of Josephine } ss.

I, Mary E Snipley, being first duly sworn, do hereby certify that I have read the foregoing Registration Statement and that all of the items therein contained are true to the best of my knowledge and belief.

Mary E Snipley
(Signature of Registrant)

Subscribed and sworn to before me this 16th day of July, 1958.

My commission expires Sept 26 1958 — Lucille L. Coyle Notary Public for Oregon
(Notary Public)

(SEAL)

CERTIFICATE OF REGISTRATION

STATE OF OREGON } ss.
County of Marion

This is to certify that the foregoing Registration Statement was received in the office of the State Engineer on the 21st day of July, 1958, at 8:00 o'clock A. M. and has been duly recorded in said office in Book No. 10 of Registration Statements on page GR-225.

Witness my hand this 10th day of March, 1959.

Arthur A. Stankov
(State Engineer)

By _____
(Deputy)

GR-225

\$15.00