

Registration Statement

OF CLAIMANT OF RIGHT TO APPROPRIATE GROUND WATER

TO THE STATE ENGINEER OF OREGON:

We, Fred E. and Rose A. Crutchley

of 450 Spring Creek Drive, Eugene County of Lane

State of Oregon, do hereby make application for a certificate of registration as evidence of a right to appropriate ground water.

1. Source from which water is withdrawn is Pump well
(Flowing well, pump well, infiltration trench, or tunnel)

2. Location is: 7 miles North of Eugene, Oregon
(Approximate distance and direction from nearest city or town)

and is more particularly described as follows:

(a) 1105 feet North and 1436.5 feet West of East 1/4 corner Section 2, T17S, R4W
(Give distance and bearing to corner of section or other legal subdivision)
being within S.W. 1/4 of N.E. 1/4 of Sec. 2, Twp. 17 South, Rge. 4 West
(Smallest legal subdivision) (N. or S.) (E. or W.)

or (b) within limits of recorded platted property, town or city:

in Lot 2, Block of
(Name of plat or addition)

County of Lane
(If within city or town, give name)

3. Construction Work was begun on May 20, 1954; was completed on same date?
(Date) (Date)

and the ground water claimed was first used for the purposes set out below on Summer 1954
(Date)

since which time the water has been used continuously
(Continuously or intermittently)

from 1954 to 1958 and still irrigating
(Date) (Date) during irrigation

4. Quantity of water claimed and used is 54 season 60 gallons per minute; 3.2 acre feet per year.

5. Purpose or Purposes for which water is used irrigation

(Domestic, irrigation, municipal, manufacturing, industrial, etc.)

6. Description of Well: Depth 20 feet. Type Driven
(Dug or drilled)

diameter 2 inches. Elevation of ground at well site 375 feet, mean sea level.
(As near as known)

Depth to water table 16 feet.

7. Capacity of Well: 55 g.p.m. with 3 feet drawdown.

 g.p.m. with feet drawdown.

Date of test

If Flowing Well: Measured discharge g.p.m. on
(Date)

Shut-in pressure at ground surface lbs. per sq. in. on
(Date)

Water is controlled by
(Cap, valve, etc.)

8. Casing: (Give diameter, commercial specifications and depth below ground surface of each casing size.)

3 1/2 inch diameter from 0 to 20 feet
 inch diameter from to feet
 inch diameter from to feet
 inch diameter from to feet

Describe and show depth of shoe, plug, adapter, liner or other details:

9. Perforated Casings or Screens:

slotted from 17 to 20
 (Number per foot and size of perforations, or describe screen)
 from to
 from to
 from to

10. Log of Well: (Describe each stratum or formation clearly, indicate if water bearing, and give thickness and depth as indicated.)

MATERIAL	Thickness (Feet)	Depth to Bottom (Feet)
Estimated Earth sandy loam	12	12
Gravel and sand	6	20
We presently have 40' x 2 1/2" pipe		
126' x 3/4" "		
100' x 1/2" "		
and use 12 - 5 gal. Sprinklers		
175 lin. ft. of Soakers		
4 rotary sprinklers		
2 small sprinklers		
miscellaneous lengths of garden hose		

If log of well is not available, give name and address of driller.

11. Infiltration Trench: Covered or open
Dimensions: Length ft. Minimum depth ft. Maximum depth ft.
Bottom width ft. Discharge g.p.m. Date of test

12. Tunnel: Type of lining
Dimensions: (Length, course, and cross sectional size)
Position of water bearing stratum with reference to portal of tunnel

Log of tunnel: (Preceding table for log of well may be used, if desired. Give footage from portal and character of materials, as pertinent.)


13. Pumping Equipment:
(a) Pump Centrifugal - Self-Priming - HomeArt Capacity 60 g.p.m.
(b) Motor Gasoline 5 1/4 H.P. Briggs Stratton 4 Cycle

14. Location of area irrigated or to be irrigated, or place of use if for purposes other than irrigation.

Township North or South	Range E. or W. of Willamette Meridian	Section	Forty-acre Tract	Number Acres To Be Irrigated	Date of Reclamation
17 South	4 West	2	SE 1/4 NE 1/4	.018	1954
17 South	4 West	2	SW 1/4 NE 1/4	1.982	
				2.000 Ac	

15. If the ground water supply is supplemental to an existing water supply, identification of any application for a permit, permit, certificate or adjudicated right to appropriate water made or held by the registrant.

Township 17 South Range 4 West W.M.
North

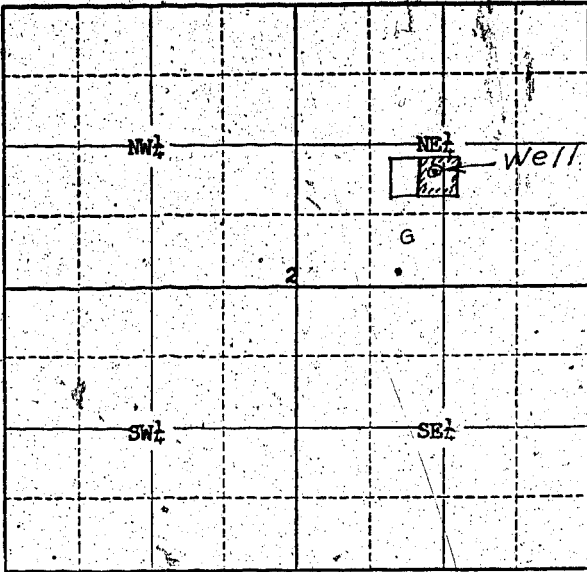

Locate well and acreage of irrigated land on plat.
Scale: 1/2" = 1 Mile

STATE OF OREGON





(Notary Public)

(SEAL)

CERTIFICATE OF REGISTRATION

STATE OF OREGON } ss.
County of Marion


Witness my hand this 10th day of March, 1959

Lewis A. Atchley
(State Engineer)

\$1500

By _____
(Deputy)

