

Registration Statement

OF CLAIMANT OF RIGHT TO APPROPRIATE GROUND WATER

(Under Chapter 708, Oregon Laws 1955.)

TO THE STATE ENGINEER OF OREGON:

I, SAM'S GARDEN

of RT 1 BOX 63 Springfield County of LANE

State of OREGON do hereby make application for a certificate of registration as evidence of a right to appropriate ground water.

1. Source from which water is withdrawn is PUMP WELL
(Flowing well, pump well, infiltration trench, or tunnel)

2. Location is: 4 MILES NE SPRINGFIELD
(Approximate distance and direction from nearest city or town)

and is more particularly described as follows:

(a) R.R. 90 FT S 75° 30' E of NW Cor. Felix South DLG
(Give distance and bearing to corner of section or other legal subdivision)

being within SE 1/4 OF THE NW 1/4 of Sec. 19, Twp. 17 S Rge. 2 W
(Smallest legal subdivision) (N. or S.) (E. or W.)

or (b) within limits of recorded platted property, town or city:

in Lot _____, Block _____ of _____
(Name of plat or addition)

County of _____
(If within city or town, give name)

3. Construction Work was begun on MAY 9, 1930; was completed on JULY 1, 1930
(Date) (Date)

and the ground water claimed was first used for the purposes set out below on JULY 15, 1930
(Date)

since which time the water has been used CONTINUOUSLY
(Continuously or intermittently)

from JULY 15, 1930 to PRESENT
(Date) (Date)

4. Quantity of water claimed and used is 116 gallons per minute; 62 acre feet per year.

5. Purpose or Purposes for which water is used _____

IRRIGATION
(Domestic, irrigation, municipal, manufacturing, industrial, etc.)

6. Description of Well: Depth 20 feet. Type DUG
(Dug or drilled)

diameter 30 inches. Elevation of ground at well site 435 feet, mean sea level.
(As near as known)

Depth to water table 14 feet.

7. Capacity of Well: ? g.p.m. with _____ feet drawdown.

? g.p.m. with _____ feet drawdown.

Date of test _____

If Flowing Well: Measured discharge _____ g.p.m. on _____
(Date)

Shut-in pressure at ground surface _____ lbs. per sq. in. on _____
(Date)

Water is controlled by _____
(Cap, valve, etc.)

8. Casing: (Give diameter, commercial specifications and depth below ground surface of each casing size.)

30 inch diameter CONCRETE TILE from SURFACE to 20' feet
 inch diameter from to feet
 inch diameter from to feet
 inch diameter from to feet

Describe and show depth of shoe, plug, adapter, liner or other details:

9. Perforated Casings or Screens:

from to
 (Number per foot and size of perforations, or describe screen)
 from to
 from to
 from to

10. Log of Well: (Describe each stratum or formation clearly, indicate if water bearing, and give thickness and depth as indicated.)

MATERIAL	Thickness (Feet)	Depth to Bottom (Feet)
LOAM	10'	10'
SAND & GRAVEL	10'	0'

If log of well is not available, give name and address of driller.

11. Infiltration Trench: Covered or open

Dimensions: Length ft. Minimum depth ft. Maximum depth ft.

Bottom width ft. Discharge g.p.m. Date of test

12. Tunnel: Type of lining

Dimensions:
(Length, course, and cross sectional size)

Position of water bearing stratum with reference to portal of tunnel

Log of tunnel: (Preceding table for log of well may be used, if desired. Give footage from portal and character of materials, as pertinent.)

13. Pumping Equipment:

(a) Pump *EMSCO CENT 2"* Capacity *120* g.p.m.
(Make, type and size)


(b) Motor *ELECTRIC 7 1/2 HP*
(Type and horsepower)

14. Location of area irrigated or to be irrigated, or place of use if for purposes other than irrigation.

Township North or South	Range E. or W. of Willamette Meridian	Section	Forty-acre Tract	Number Acres To Be Irrigated	Date of Reclamation
<i>17S</i>	<i>2W</i>	<i>19</i>	<i>NE 1/4 SW 1/4</i>	<i>5.6</i>	<i>JULY 15, 1930</i>
<i>17S</i>	<i>2W</i>	<i>19</i>	<i>SE 1/4 NW 1/4</i>	<i>15.0</i>	<i>" " "</i>
				<i>20.6</i>	

15. If the ground water supply is supplemental to an existing water supply, identification of any application for a permit, permit, certificate or adjudicated right to appropriate water made or held by the registrant.

Township 27 S Range 2 W, W.M.
North

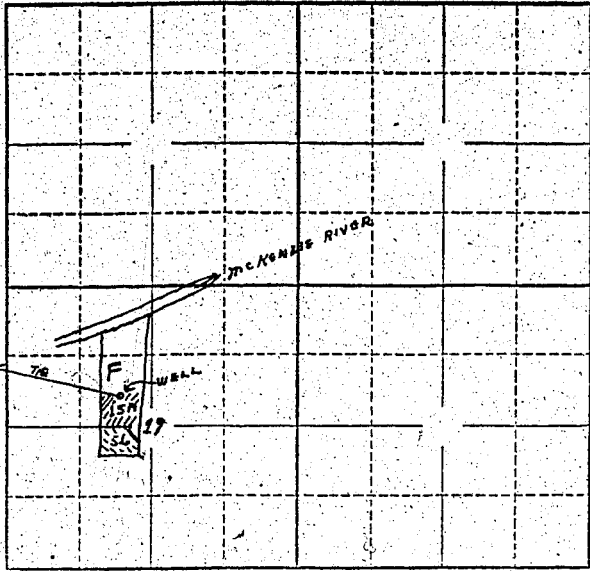

NW. CORNER OF THE
FELIX SCOTTER & WIFE
D.A.C.

Locate well and acreage of irrigated land on plat.
Scale: 2" = 1 Mile

STATE OF OREGON }
County of } ss.

I, _____, being first duly sworn, do hereby certify that I have read the foregoing Registration Statement and that all of the items therein contained are true to the best of my knowledge and belief.

Samie Garden
by Dab E. Rothelomew
(Signature of Registrant)

Subscribed and sworn to before me this 2nd day of April, 1958

My commission expires Aug 31, 1958
Harry E. Spittle
(Notary Public)

(SEAL)

CERTIFICATE OF REGISTRATION

STATE OF OREGON }
County of Marion } ss.

This is to certify that the foregoing Registration Statement was received in the office of the State Engineer on the 21st day of July, 1958, at 8:00 o'clock A. M. and has been duly recorded in said office in Book No. 10 of Registration Statements on page GR-2262

~~Construction shall be completed by _____ 19____ and the water completed by _____~~
~~beneficial by _____ 19____~~

Witness my hand this 10th day of March, 1959

Herold G. Stanley
(State Engineer)

\$1,500

By _____
(Deputy)