

Registration Statement

OF CLAIMANT OF RIGHT TO APPROPRIATE GROUND WATER

(Under Chapter 708, Oregon Laws 1955.)

TO THE STATE ENGINEER OF OREGON:

I, SAM'S GARDEN

of RT 1 BOX 63 - Springfield County of LANE

State of OREGON, do hereby make application for a certificate of registration as evidence of a right to appropriate ground water.

1. Source from which water is withdrawn is PUMP WELL
(Flowing well, pump well, infiltration trench, or tunnel)

2. Location is: 7 MILES N.E. SPRINGFIELD
(Approximate distance and direction from nearest city or town)

and is more particularly described as follows:

(a) 22.75 FT. N. 86° 15' E. OF THE M.W.C. OF THE FELIX SCOTT SR. D.C.
(Give distance and bearing to corner of section or other legal subdivision)

being within SE 1/4 OF THE N.W. 1/4 of Sec. 19, Twp. 17 S, Rge. 2 W
(Smallest legal subdivision) (N. or S.) (E. or W.)

or (b) within limits of recorded platted property, town or city:

in Lot _____, Block _____ of _____
(Name of plat or addition)

County of _____
(If within city or town, give name)

3. Construction Work was begun on JUNE 10, 1942; was completed on SEPT. 5, 1942
(Date) (Date)

and the ground water claimed was first used for the purposes set out below on MAY 15, 1942
(Date)

since which time the water has been used CONTINUOUSLY
(Continuously or intermittently)

from MAY 15, 1942 to PRESENT
(Date) (Date)

4. Quantity of water claimed and used is 166 gallons per minute; 89 acre feet per year.

5. Purpose or Purposes for which water is used

IRRIGATION
(Domestic, irrigation, municipal, manufacturing, industrial, etc.)

6. Description of Well: Depth 10 feet, Type DUG
(Dug or drilled)

diameter 4.8 inches. Elevation of ground at well site 425 feet, mean sea level.
(As near as known)

Depth to water table 4 feet.

7. Capacity of Well: _____ g.p.m. with _____ feet drawdown.

_____ g.p.m. with _____ feet drawdown.


Date of test _____

If Flowing Well: Measured discharge _____ g.p.m. on _____
(Date)

Shut-in pressure at ground surface _____ lbs. per sq. in. on _____
(Date)

Water is controlled by _____
(Cap, valve, etc.)

Township 17 S Range 2 W, W.M.
North

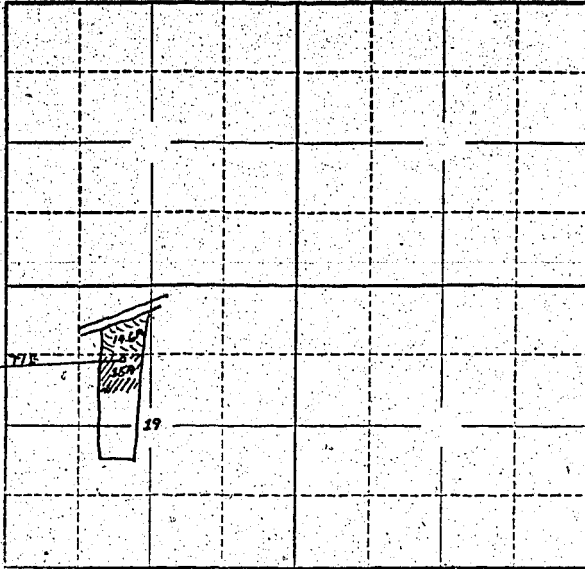

N.W.C. OF THE
FELIX SCOTT SR. WIFE
RLC.

Locate well and acreage of irrigated land on plat.
Scale: 2" = 1 Mile

STATE OF OREGON }
County of _____ } ss.

I, _____, being first duly sworn, do hereby certify that I have read the foregoing Registration Statement and that all of the items therein contained are true to the best of my knowledge and belief.

Louis Gordon
Aug 26 58
(Signature of Registrant)

Subscribed and sworn to before me this 2nd day of April, 1958

My commission expires Aug 31, 1958
Henry G. [Signature]
(Notary Public)

(SEAL)

CERTIFICATE OF REGISTRATION

STATE OF OREGON }
County of Marion } ss.

This is to certify that the foregoing Registration Statement was received in the office of the State Engineer on the 21st day of July, 1958, at 2:00 o'clock A. M. and has been duly recorded in said office in Book No. 10 of Registration Statements on page GR-2263

~~Consent to the study has been completed by _____ and the water completely applied to _____~~

Witness my hand this 10th day of March, 1959

Claris A. [Signature]
(State Engineer)

By _____
(Deputy)

GR-2263

1500