

# Registration Statement

## OF CLAIMANT OF RIGHT TO APPROPRIATE GROUND WATER

TO THE STATE ENGINEER OF OREGON:

I, Grover C. Smith

of Rt. 4, Box 303, Corvallis County of Linn  
(Mailing address)

State of Oregon, do hereby make application for a certificate of registration as evidence of a right to appropriate ground water.

1. Source from which water is withdrawn is pump well  
(Flowing well, pump well, infiltration trench, or tunnel)

2. Location is: 1 1/2 miles NE of Corvallis, Oregon  
(Approximate distance and direction from nearest city or town)

and is more particularly described as follows:

(a) 1025 feet south and 270 feet west from N 1/4 corner Section 36  
(Give distance and bearing to corner of section or other legal subdivision)

being within NE 1/4 of NW 1/4 of Sec. 36, Twp. 11 S, Rge. 5 W  
(Smallest legal subdivision) (N, S, E, or W)

or (b) within limits of recorded platted property, town or city:

in Lot \_\_\_\_\_, Block \_\_\_\_\_ of \_\_\_\_\_  
(Name of plat or addition)

County of Linn  
(If within city or town, give name)

3. Construction Work was begun on 1935; was completed on 1935  
(Date) (Date)

and the ground water claimed was first used for the purposes set out below on 1935  
(Date)

since which time the water has been used continuously  
(Continuously or Intermittently)

from 1935 to present time  
(Date) (Date)

4. Quantity of water claimed and used is 900 gallons per minute; 135.0 acre feet per year.

5. Purpose or Purposes for which water is used Irrigation

(Domestic, irrigation, municipal, manufacturing, industrial, etc.)

6. Description of Well: Depth 34 feet. Type Dug  
(Dug or drilled)

diameter 30 inches. Elevation of ground at well site 200 feet, mean sea level.  
(As near as known)

Depth to water table 17 feet.

7. Capacity of Well: \_\_\_\_\_ g.p.m. with \_\_\_\_\_ feet drawdown.

\_\_\_\_\_ g.p.m. with \_\_\_\_\_ feet drawdown.

Date of test Not tested

If Flowing Well: Measured discharge \_\_\_\_\_ g.p.m. on \_\_\_\_\_  
(Date)


Shut-in pressure at ground surface \_\_\_\_\_ lbs. per sq. in. on \_\_\_\_\_  
(Date)

Water is controlled by \_\_\_\_\_  
(Cap, valve, etc.)





Township 11 S Range 5 W, W.M.  
North

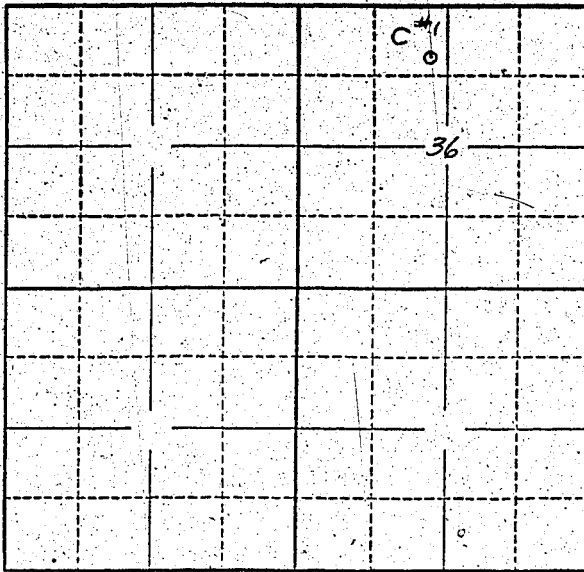

Locate well and acreage of irrigated land on plat.  
Scale: 2" = 1 Mile

STATE OF OREGON }  
County of LINN } ss.

I, Grover C. Smith, being first duly sworn, do hereby certify that I have read the foregoing Registration Statement and that all of the items therein contained are true to the best of my knowledge and belief.

Grover C. Smith  
(Signature of Registrant)

Subscribed and sworn to before me this 12<sup>th</sup> day of July, 1958.

My commission expires 11-16-59  
(Notary Public)

(SEAL)

**CERTIFICATE OF REGISTRATION**

STATE OF OREGON }  
County of Marion } ss.

This is to certify that the foregoing Registration Statement was received in the office of the State Engineer on the 21 day of July, 1958, at 8:00 o'clock A. M. and has been duly recorded in said office in Book No. 10 of Registration Statements on page GR 2265

Witness my hand this 10<sup>th</sup> day of March, 1959

Claris A. Stanley  
(State Engineer)

By \_\_\_\_\_  
(Deputy)

GR - 2265

\$17.25