

Registration Statement

OF CLAIMANT OF RIGHT TO APPROPRIATE GROUND WATER

TO THE STATE ENGINEER OF OREGON:

I, B. F. and Borghild Sumption

of P. O. Box 11, Crabtree, Oregon County of Linn
(Mailing address)

State of Oregon, do hereby make application for a certificate of registration as evidence of a right to appropriate ground water.

1. Source from which water is withdrawn is pump well
(Flowing well, pump well, infiltration trench, or tunnel)

2. Location is: in Crabtree, Oregon
(Approximate distance and direction from nearest city or town)

and is more particularly described as follows:

(a) 396' S. and 2376' E. of NW corner S. 11, T. 10S, R. 2W
(Give distance and bearing to corner of section or other legal subdivision)

being within NE¹/₄ of NW¹/₄ of Sec. 11, Twp. 10S, Rge. 2W
(Smallest legal subdivision) (N. or S.) (E. or W.)

or (b) within limits of recorded platted property, town or city:

in Lot _____, Block _____ of _____
(Name of plat or addition)

County of Linn
(If within city or town, give name)

3. Construction Work was begun on 1909; was completed on 1909
(Date) (Date)

and the ground water claimed was first used for the purposes set out below on 1948
(Date)

since which time the water has been used intermittently
(Continuously or intermittently)

from 1948 to present time
(Date) (Date)

4. Quantity of water claimed and used is 178 gallons per minute; 10.5 acre feet per year.

5. Purpose or Purposes for which water is used Irrigation and Domestic

(Domestic, irrigation, municipal, manufacturing, industrial, etc.)

6. Description of Well: Depth 18 feet. Type Dug
(Dug or drilled)

diameter 6' inches. Elevation of ground at well site 260 feet, mean sea level.
(As near as known)

Depth to water table 4 feet.

7. Capacity of Well: _____ g.p.m. with _____ feet drawdown.

_____ g.p.m. with _____ feet drawdown.

Date of test Not tested


If Flowing Well: Measured discharge _____ g.p.m. on _____
(Date)

Shut-in pressure at ground surface _____ lbs. per sq. in. on _____
(Date)

Water is controlled by _____
(Cap, valve, etc.)

Township 10S Range 2W, W.M.

North

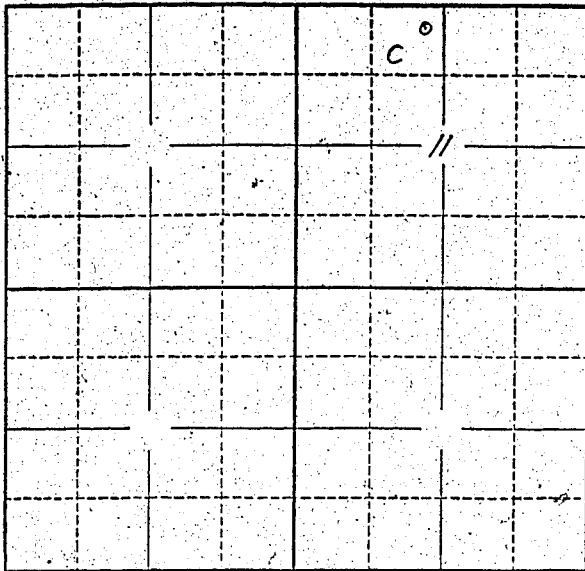

Locate well and acreage of irrigated land on plat.
Scale: 2" = 1 Mile

STATE OF OREGON

County of Linn

} ss.

I, B. F. and Berghild Sumption, being first duly sworn, do hereby certify that I have read the foregoing Registration Statement and that all of the items therein contained are true to the best of my knowledge and belief.

Subscribed and sworn to before me this 18th day of July, 1958

My commission expires May 11, 1960

(Signature of Registrant)

(Notary Public for Oregon)

(SEAL)

CERTIFICATE OF REGISTRATION

STATE OF OREGON

County of Marion

} ss.

This is to certify that the foregoing Registration Statement was received in the office of the State Engineer on the 21 day of July, 1958, at 8:00 o'clock A.M. and has been duly recorded in said office in Book No. 10 of Registration Statements on page GR-2266

Witness my hand this 10th day of March, 1959

(State Engineer)

By

(Deputy)

GR-2266