

Registration Statement

OF CLAIMANT OF RIGHT TO APPROPRIATE GROUND WATER

(Under Chapter 708, Oregon Laws 1955.)

TO THE STATE ENGINEER OF OREGON:

I, Warren Donner, City Water Superintendent

of City of Woodburn County of Marion

State of Oregon, do hereby make application for a certificate of registration as evidence of a right to appropriate ground water.

1. Source from which water is withdrawn is a pump well #4
(Flowing well, pump well, infiltration trench, or tunnel)

2. Location is: within the city limits of the City of Woodburn, Oregon
(Approximate distance and direction from nearest city or town)

and is more particularly described as follows: 1420 feet east and 780 feet north from SW corner Section 9

(a) (See description on last page)
(Give distance and bearing to corner of section or other legal subdivision)

being within SE 1/4 of SW 1/4 of Sec. 7, Twp. 5 S., Rge. 1 W.
(Smallest legal subdivision) (N. or S.) (E. or W.)

or (b) within limits of recorded platted property, town or city:

in Lot _____, Block _____ of _____
(Name of plat or addition)

Woodburn County of Marion
(If within city or town, give name)

3. Construction Work was begun on July, 1952; was completed on August 7, 1952
(Date) (Date)

and the ground water claimed was first used for the purposes set out below on September, 1952
(Date)

since which time the water has been used continuously
(Continuously or Intermittently)

from Sept. 1952 to date of this statement
(Date) (Date)

4. Quantity of water claimed and used is 500 gallons per minute; 1.5 acre feet per year.

5. Purpose or Purposes for which water is used _____

municipal water supply, City of Woodburn
(Domestic, irrigation, municipal, manufacturing, industrial, etc.)

6. Description of Well: Depth 183 feet. Type Drilled
(Dug or drilled)

diameter 12 inches. Elevation of ground at well site 181 feet, mean sea level.
(As near as known)

Depth to water table 42 feet.

7. Capacity of Well: 550 g.p.m. with 14 feet drawdown.

_____ g.p.m. with _____ feet drawdown.

Date of test May 10, 1958

If Flowing Well: Measured discharge _____ g.p.m. on NOT APPLICABLE
(Date)

Shut-in pressure at ground surface _____ lbs. per sq. in. on _____
(Date)

Water is controlled by _____
(Cap, valve, etc.)

8. Casing: (Give diameter, commercial specifications and depth below ground surface of each casing size.)

.....12..... inch diameter standard from surface to 180 feet
 inch diameter from to feet
 inch diameter from to feet
 inch diameter from to feet

Describe and show depth of shoe, plug, adapter, liner or other details:

9. Perforated Casings or Screens:

..... Perforated from 166 to 175
 (Number per foot and size of perforations, or describe screen)
 from to
 from to
 from to

10. Log of Well: (Describe each stratum or formation clearly, indicate if water bearing, and give thickness and depth as indicated.)

MATERIAL	Thickness (Feet)	Depth to Bottom (Feet)
Topsoil and clay-water at 12'	1 to 12	12
Silt and sand	12 " 68	68
Tight sand formation	68 " 75	75
Sandy clay	75 " 84	84
Cemented compact sand	84 " 115	115
Sand and small gravel	115 " 129	129
Blue clay	129 " 144	144
Sand	144 " 163	163
Gravel, sand, water bearing	163 " 173	173
Sand, free running at 190'	173 " 191	191

If log of well is not available, give name and address of driller.

11. Infiltration Trench: Covered or open

Dimensions: Length ft. Minimum depth ft. Maximum depth ft.
 Bottom width ft. Discharge g.p.m. Date of test

12. Tunnel: Type of lining

Dimensions:
(Length, course, and cross sectional size)
 Position of water bearing stratum with reference to portal of tunnel

Log of tunnel: (Preceding table for log of well may be used, if desired. Give footage from portal and character of materials, as pertinent.)

13. Pumping Equipment;

(a) Pump Multiple stage vertical turbine Capacity 550 g.p.m.
(Make, type and size)
 (b) Motor Jacuzzi, 3 phase electric 40 h.p. & gasoline auxiliary
(Type and horsepower)

14. Location of area irrigated or to be irrigated, or place of use if for purposes other than irrigation.


Township North or South	Range E. or W. of Willamette Meridian	Section	Forty-acre Tract	Number Acres To Be Irrigated	Date of Reclamation
Water is pumped into central municipal water supply system used throughout the City of Woodburn, which lies within the boundaries of Township 5 S., R. 1 W., W.M.					
(Data by 40 acre tracts therein not being available at City Hall, State Engineer may determine these data from public records of his office if necessary, although water pumped from these wells is not used on a specific 40-acre tract or other sized tract other than within and throughout the City of Woodburn.)					
T5S	R1W	7	all S ¹ / ₂	municipal	1952
"	"	8	all SW ¹ / ₄	"	"
"	"	18	all N ¹ / ₂	"	"
"	"	17	all NW ¹ / ₄	"	"

15. If the ground water supply is supplemental to an existing water supply, identification of any application for a permit, permit, certificate or adjudicated right to appropriate water made or held by the registrant.

NOT APPLICABLE

Beginning at a point on the northerly line of Hayes Street produced and the westerly line of Settlemier Avenue; thence N. 48 degrees 45' W. a distance of 60.02 feet to point on the southerly line of Bottle Avenue; thence S. 88 degrees 31' E. along the southerly line of Bottle Avenue a distance of 54.18 feet to a point on the westerly line of Settlemier Avenue; thence S. 13 degrees 18' W. a distance of 39.23 feet along said westerly line of Settlemier Avenue to the place of beginning.

Township 55 Range 1W W.M.
North

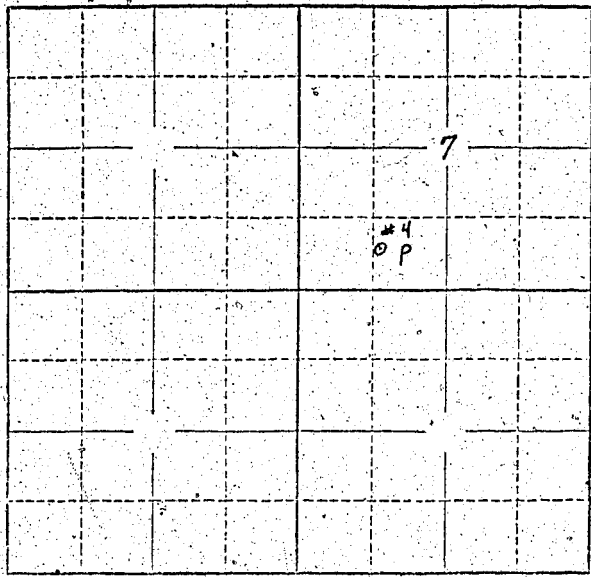

Locate well and acreage of irrigated land on plat.
Scale: 2" = 1 Mile

STATE OF OREGON }
County of Marion } ss.

I, Warren Donner, being first duly sworn, do hereby certify that I have read the foregoing Registration Statement and that all of the items therein contained are true to the best of my knowledge and belief.

Warren Donner
(Signature of Registrant)

Subscribed and sworn to before me this 6th day of June, 1958.

My commission expires March 18, 1959

David A. Eschallast
(Notary Public) for Oregon
My Commission Expires
March 18, 1959

(SEAL)

CERTIFICATE OF REGISTRATION

STATE OF OREGON }
County of Marion } ss.

This is to certify that the foregoing Registration Statement was received in the office of the State Engineer on the 21st day of July, 1958, at 8:00 o'clock A.M. and has been duly recorded in said office in Book No. 10 of Registration Statements on page GR-2270

~~Construction shall be completed by 10 and the water completely applied to beneficial use by 10~~

Witness my hand this 10th day of March, 1959

Willie R. Blodgett
(State Engineer)

\$ 22.00

By _____ (Deputy)

GR-2270