RECEIVED
MAY 24 1956

REGISTRATION NO. GR-239
CERTIFICATE NO. GR-228

Registration Statement

OF CLAIMANT OF RIGHT TO APPROPRIATE GROUND WATER

(Under Chapter 708, Oregon Laws 1955.)

TO THE STATE ENGINEER OF OREGON:

I, Willamette Cherry Growers, Inc., 1520 Woodrow St., Salem, Oregon.

of Salem County of Marion

State of Oregon, do hereby make application for a certificate of registration as evidence of a right to appropriate ground water.

1. **Source** from which water is withdrawn is pump well (Flowing well, pump well, infiltration trench, or tunnel)

2. **Location is:** Salem, Oregon See map attached (Approximate distance and direction from nearest city or town);

and is more particularly described as follows:

(a) 780 feet North and 300 feet east from SW corner of SE ¼ of section 14 (Give distance and bearing to corner of section or other legal subdivision)

See Map attached

being within SE¼ of SE¼ (Smallest legal subdivision) of Sec. 14, Twp. 7S (N. or S.), Rge. 3W (E. or W.)

or (b) within limits of recorded platted property, town or city:

in Lot 13, Block 2 of Fairgrove Addition (Name of plat or addition)

Salem (If within city or town, give name) County of Marion

3. **Construction Work** was begun on prior to 1927 (Date) unknown; was completed on prior to 1927 (Date)

and the ground water claimed was first used for the purposes set out below on prior to 1927 (Date);

since which time the water has been used continuously (Continuously or intermittently)

from 1934 (Date) to present (Date)

4. **Quantity** of water claimed and used is 200 gallons per minute; ..... acre feet per year.

5. **Purpose or Purposes** for which water is used mamufacturing

(Domestic, irrigation, municipal, manufacturing, industrial, etc.)

6. **Description of Well:** Depth 283½ feet. Type drilled (Dug or drilled)

diameter 8 inches. Elevation of ground at well site 160 (As near as known) feet, mean sea level.

Depth to water table 24 feet.

7. **Capacity of Well:** not known g.p.m. with 40 feet drawdown.

..... g.p.m. with ..... feet drawdown.

Date of test .....

If Flowing Well: Measured discharge ..... g.p.m. on ..... (Date)

Shut-in pressure at ground surface ..... lbs. per sq. in. on ..... (Date)

Water is controlled by ..... (Cap, valve, etc.)

8. **Casing:** (Give diameter, commercial specifications and depth below ground surface of each casing size.)

8 inch diameter from 0 to 180 feet

6 inch diameter from 180 to 283½ feet

____ inch diameter from ____ to ____ feet

____ inch diameter from ____ to ____ feet

Describe and show depth of shoe, plug, adapter, liner or other details:

unknown

9. **Perforated Casings or Screens:**

unknown from ____ to ____
(Number per foot and size of perforations, or describe screen)

____ from ____ to ____

____ from ____ to ____

____ from ____ to ____

10. **Log of Well:** (Describe each stratum or formation clearly, indicate if water bearing, and give thickness and depth as indicated.)

MATERIAL	Thickness (Feet)	Depth to Bottom (Feet)
unknown		

GR- 228 A

If log of well is not available, give name and address of driller .....

11. **Infiltration Trench:** Covered or open .....

Dimensions: Length ..... ft. Minimum depth ..... ft. Maximum depth ..... ft.

Bottom width ..... ft. Discharge ..... g.p.m. Date of test .....

12. **Tunnel:** Type of lining .....

Dimensions: ..... (Length, course, and cross sectional size)

Position of water bearing stratum with reference to portal of tunnel .....

Log of tunnel: (Preceding table for log of well may be used, if desired. Give footage from portal and character of materials, as pertinent.)

13. **Pumping Equipment:**

(a) Pump Johnson Turbine (Make, type and size) Capacity 200 g.p.m.

(b) Motor 10 HP 1800 RPM (Type and horsepower)

14. Location of area irrigated or to be irrigated, or place of use if for purposes other than irrigation.

Township North or South	Range E. or W. of Willamette Meridian	Section	Forty-acre Tract	Number Acres To Be Irrigated / Use	Date of Reclamation
T 7 S	R 3 W	14	SE¼ of SE¼	Manufacturing	1927
			no irrigation		

15. If the ground water supply is supplemental to an existing water supply, identification of any application for a permit, permit, certificate or adjudicated right to appropriate water made or held by the registrant.

.....

.....

GR-228 B

See Map attached

Township 7S Range 3W, W.M.

North

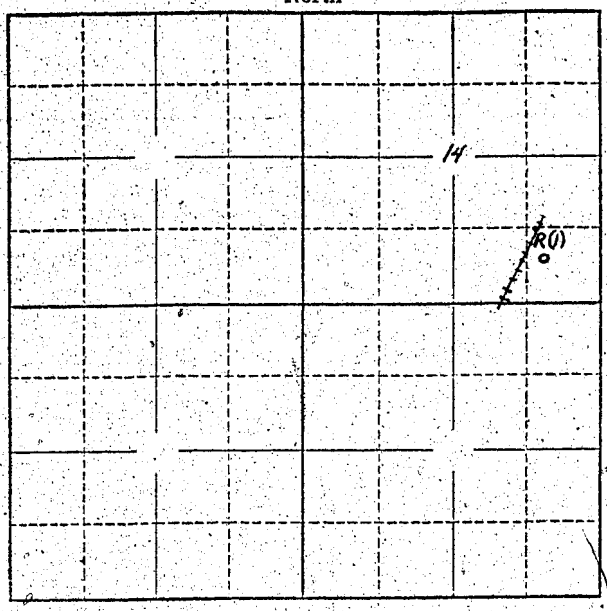

Locate well and acreage of irrigated land on plat.

Scale: 2" = 1 Mile

STATE OF OREGON
County of MARION } ss.

I, Robt. E. Shinn, being first duly sworn, do hereby certify that I have read the foregoing Registration Statement and that all of the items therein contained are true to the best of my knowledge and belief.

WILLAMETTE CHERRY GROWERS, INC.

BY: Robt. E. Shinn, Manager
(Signature of Registrant)

Subscribed and sworn to before me this 23rd day of May, 1956

My commission expires June 2, 1958 Leo Masters
(Notary Public)

(SEAL)

CERTIFICATE OF REGISTRATION

STATE OF OREGON
County of Marion } ss.

This is to certify that the foregoing Registration Statement was received in the office of the State Engineer on the 21st day of August, 1956, at 8 o'clock A. M. and has been duly recorded in said office in Book No. 2 of Registration Statements on page GR-228 C

~~Construction shall be completed by x-x-x-x-x-x-x-x-x-x-x-x and the water applied to beneficial use by x-x-x-x-x-x-x-x-x-x-x-x~~

Witness my hand this 23rd day of November, 1956

Edward A. Stanley
(State Engineer)

By _____
(Deputy)

GR-228 C