

# Registration Statement

## OF CLAIMANT OF RIGHT TO APPROPRIATE GROUND WATER

**TO THE STATE ENGINEER OF OREGON:**

I, Edward and Joan Douglas  
of Route 2, Box 194, Lebanon County of Linn  
(Mailing address)

State of Oregon, do hereby make application for a certificate of registration as evidence of a right to appropriate ground water.

1. Source from which water is withdrawn is pump well  
(Flowing well, pump well, infiltration trench, or tunnel)
2. Location is: four miles N. of Lebanon, Oregon  
(Approximate distance and direction from nearest city or town)

and is more particularly described as follows:

(a) N. 45° 15' W. 28.2 chains from SE corner DIC 57  
(Give distance and bearing to corner of section or other legal subdivision)  
being within NW $\frac{1}{4}$  of NE $\frac{1}{4}$  of Sec. 35, Twp. 11S Rge. 2W  
(Smallest legal subdivision) (N. or S.) (E. or W.)

or (b) within limits of recorded platted property, town or city:  
in Lot \_\_\_\_\_, Block \_\_\_\_\_ of \_\_\_\_\_  
(Name of plat or addition)  
County of Linn  
(If within city or town, give name)

3. Construction Work was begun on 1952 was completed on 1952  
(Date) (Date)

and the ground water claimed was first used for the purposes set out below on 1952  
(Date)  
since which time the water has been used continuously  
(Continuously or intermittently)  
from 1952 to present time  
(Date) (Date)

4. Quantity of water claimed and used is 272 gallons per minute; 200.4 acre feet per year.

5. Purpose or Purposes for which water is used Irrigation  
(Domestic, irrigation, municipal, manufacturing, industrial, etc.)

6. Description of Well: Depth 26 feet. Type Drilled  
(Dug or drilled)  
diameter 10 inches. Elevation of ground at well site 310 feet, mean sea level.  
(As near as known)  
Depth to water table 14 feet.

7. Capacity of Well: 500 g.p.m. with 16 feet drawdown.  
\_\_\_\_\_ g.p.m. with \_\_\_\_\_ feet drawdown.  
Date of test 1952

If Flowing Well: Measured discharge \_\_\_\_\_ g.p.m. on \_\_\_\_\_  
(Date)

Shut-in pressure at ground surface \_\_\_\_\_ lbs. per sq. in. on \_\_\_\_\_  
(Date)

Water is controlled by \_\_\_\_\_  
(Cap, valve, etc.)

8. Casing: (Give diameter, commercial specifications and depth below ground surface of each casing size.)

10 inch diameter Steel casing from 0 to 26 feet  
 inch diameter from to feet  
 inch diameter from to feet  
 inch diameter from to feet

Describe and show depth of shoe, plug, adapter, liner or other details:

9. Perforated Casings or Screens:

Slotted perforations from 16 to 26 feet

(Number per foot and size of perforations, or describe screen)

from to

from to

from to

10. Log of Well: (Describe each stratum or formation clearly, indicate if water bearing, and give thickness and depth as indicated.)

MATERIAL	Thickness (Feet)	Depth to Bottom (Feet)
Not available		

If log of well is not available, give name and address of driller. B111 Hamilton Drilling

Company 838 E. Third Ave., Albany, Oregon

11. Infiltration Trench: Covered or open .....

Dimensions: Length ..... ft. Minimum depth ..... ft. Maximum depth ..... ft.

Bottom width ..... ft. Discharge ..... g.p.m. Date of test .....

12. Tunnel: Type of lining .....

Dimensions: .....  
(Length, course, and cross sectional size)

Position of water bearing stratum with reference to portal of tunnel .....

Log of tunnel: (Preceding table for log of well may be used, if desired. Give footage from portal and character of materials, as pertinent.)

13. Pumping Equipment:

(a) Pump Gould 3" Centrifugal ..... Capacity 180 ..... g.p.m.  
(Make, type and size)

(b) Motor 20 " P. Electric .....  
(Type and horsepower)


14. Location of area irrigated or to be irrigated, or place of use if for purposes other than irrigation.

Township North or South	Range E. or W. of Willamette Meridian	Section	Four-acre Tract	Number Acres To Be Irrigated	Date of Reclamation
11S	2W	26	SW <sub>1/4</sub> of SE <sub>1/4</sub>	30.6	1952
11S	2W	26	SE <sub>1/4</sub> of SE <sub>1/4</sub>	1.4	1952
11S	2W	35	NW <sub>1/4</sub> of NE <sub>1/4</sub>	25.7	1952
11S	2W	35	SW <sub>1/4</sub> of NE <sub>1/4</sub>	7.0	1952
11S	2W	35	SE <sub>1/4</sub> of NE <sub>1/4</sub>	0.5	1952
11S	2W	35	NE <sub>1/4</sub> of NE <sub>1/4</sub>	1.6	1952
				66.8	

15. If the ground water supply is supplemental to an existing water supply, identification of any application for a permit, permit, certificate or adjudicated right to appropriate water made or held by the registrant.

Township 11S Range 2W, W.M.

North

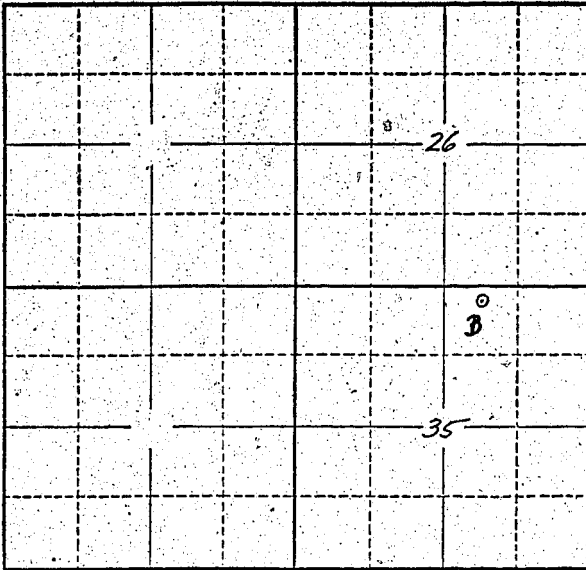

Locate well and acreage of irrigated land on plat.

Scale: 2" = 1 Mile

STATE OF OREGON

County of Linn } ss.

I, Edward and Joan Douglas, being first duly sworn, do hereby certify that I have read the foregoing Registration Statement and that all of the items therein contained are true to the best of my knowledge and belief.

*Edward Douglas*  
\_\_\_\_\_  
(Signature of Registrant)

Subscribed and sworn to before me this 16<sup>th</sup> day of July, 1958

My commission expires 11-21-66

*Ray McRay*  
\_\_\_\_\_  
(Notary Public)

(SEAL)

CERTIFICATE OF REGISTRATION

STATE OF OREGON } ss.  
County of Marion

This is to certify that the foregoing Registration Statement was received in the office of the State Engineer on the 21 day of July, 1958, at 8:00 o'clock A.M. and has been duly recorded in said office in Book No. 10 of Registration Statements on page GR-2271

Witness my hand this 10<sup>th</sup> day of March, 1959

*Elmer A. Hottel*  
\_\_\_\_\_  
(State Engineer)

# 20-55

By \_\_\_\_\_ (Deputy)

GR - 2271