

Registration Statement

OF CLAIMANT OF RIGHT TO APPROPRIATE GROUND WATER

TO THE STATE ENGINEER OF OREGON:

I, Fred and Georgina Vedder
of 19800 S.W. Martin Drive Beaverton County of Washington
(Mailing address)

State of Oregon do hereby make application for a certificate of registration as evidence of a right to appropriate ground water.

1. Source from which water is withdrawn is Pump well
(Flowing well, pump well, infiltration, trench, or tunnel)

2. Location is: Town of Aloha - 2 miles north
(Approximate distance and direction from nearest city or town)

and is more particularly described as follows:

(a) 700', 18° N. of W. from S.E. corner of section 24
(Give distance and bearing to corner of section or other legal subdivision)

being within SE 1/4 of SE 1/4 of Sec. 24, Twp. 1 S, Rge. 2 W
(Smallest legal subdivision) (N. or S.) (E. or W.)

or (b) within limits of recorded platted property, town or city:

in Lot _____ Block _____ of _____
(Name of plat or addition)

County of _____
(If within city or town, give name)

3. Construction Work was begun on July 1, 1955; was completed on July 25, 1955
(Date) (Date)

and the ground water claimed was first used for the purposes set out below on July 25, 1955
(Date)

since which time the water has been used continuously
(Continuously or Intermittently)

from July 25, 1955 to Oct 1958
(Date) (Date)

4. Quantity of water claimed and used is 9 gallons per minute; _____ acre feet per year.

5. Purpose or Purposes for which water is used (exempt) ~~irrigation~~ irrigation

(Domestic, irrigation, municipal, manufacturing, industrial, etc.)

6. Description of Well: Depth 10.8 feet. Type drilled
(Dug or drilled)

diameter 6 inches. Elevation of ground at well site _____ feet, mean sea level.
(As near as known)

Depth to water table _____ feet.

7. Capacity of Well: 7 g.p.m. with _____ feet drawdown.

_____ g.p.m. with _____ feet drawdown.

Date of test July 1, 1955

If Flowing Well: Measured discharge _____ g.p.m. on _____
(Date)

Shut-in pressure at ground surface _____ lbs. per sq. in. on _____
(Date)

Water is controlled by _____
(Cap, valve, etc.)

8. Casing: (Give diameter, commercial specifications and depth below ground surface of each casing size.)

6 inch diameter Case from 0 to 18 feet

inch diameter in solid Rock from 18 to 108 feet

inch diameter from to feet

inch diameter from to feet

Describe and show depth of shoe, plug, adapter, liner or other details:

.....

.....

9. Perforated Casings or Screens:

..... from to

(Number per foot and size of perforations, or describe screen)

..... from to

..... from to

..... from to

10. Log of Well: (Describe each stratum or formation clearly, indicate if water bearing, and give thickness and depth as indicated.)

MATERIAL	Thickness (Feet)	Depth to Bottom (Feet)
Clay	18	18
Rock	90	108

If log of well is not available, give name and address of driller. Paul Ross Mt 4-5342
2040 S.W. 192 Ave - Beaverton, Oregon

11. Infiltration Trench: Covered or open

Dimensions: Length ft. Minimum depth ft. Maximum depth ft.

Bottom width ft. Discharge g.p.m. Date of test

12. Tunnel: Type of lining

Dimensions:
(Length, course, and cross sectional size)

Position of water bearing stratum with reference to portal of tunnel

Log of tunnel: (Preceding table for log of well may be used, if desired. Give footage from portal and character of materials, as pertinent.)

13. Pumping Equipment:

(a) Pump Homair pump (jet) Capacity 9 g.p.m.
(Make, type and size)


(b) Motor Electric motor 1 horsepower
(Type and horsepower)

14. Location of area irrigated or to be irrigated, or place of use if for purposes other than irrigation.

Township North or South	Range E. or W. of Willamette Meridian	Section	Forty-acre Tract	Number Acres To Be Irrigated	Date of Reclamation
<u>1 S.</u>	<u>2 W</u>	<u>24</u>	<u>SE 1/4 of SE 1/4</u>	<u>1.8</u>	<u>1955</u>

15. If the ground water supply is supplemental to an existing water supply, identification of any application for a permit, permit, certificate or adjudicated right to appropriate water made or held by the registrant.

Township 15 Range 2W, W.M.
North

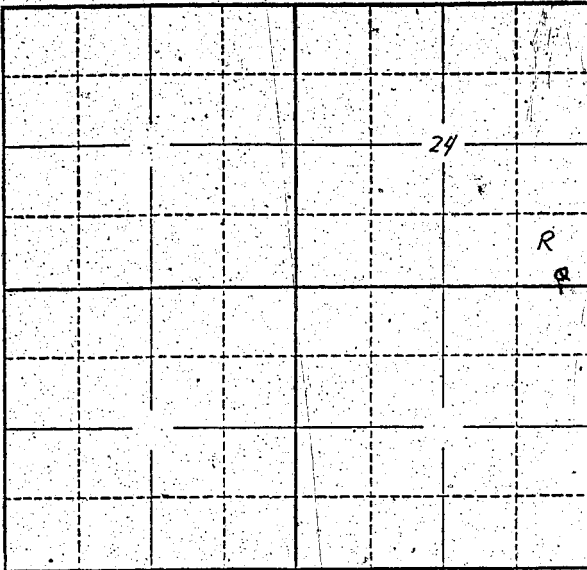

Locate well and acreage of irrigated land on plat.
Scale: 2" = 1 Mile

STATE OF OREGON

County of Washington } ss.

I, Fred Vaddor & Georgina Vaddor, being first duly sworn, do hereby certify that I have read the foregoing Registration Statement and that all of the items therein contained are true to the best of my knowledge and belief.

Fred Vaddor - Georgina Vaddor
(Signature of Registrant)

Subscribed and sworn to before me this 17 day of July, 1959

My commission expires March 10 1960 (Notary Public)

(SEAL)

CERTIFICATE OF REGISTRATION

STATE OF OREGON

County of Marion } ss.

This is to certify that the foregoing Registration Statement was received in the office of the State Engineer on the 21st day of July, 1959, at 8:00 o'clock A.M. and has been duly recorded in said office in Book No. 10 of Registration Statements on page GR 2274

Witness my hand this 10th day of March, 1959

Lusia W. [Signature]
(State Engineer)

By _____ (Deputy)

GR - 2274

1520