

Registration Statement

OF CLAIMANT OF RIGHT TO APPROPRIATE GROUND WATER

TO THE STATE ENGINEER OF OREGON:

I, Charles W. and Patricia M. Chambers

of Route 2, Box 329, Albany County of Linn

State of Oregon, do hereby make application for a certificate of registration as evidence of a right to appropriate ground water.

1. Source from which water is withdrawn is pump well
(Flowing well, pump well, infiltration trench, or tunnel)

2. Location is: 11 miles N. of Albany, Oregon.
(Approximate distance and direction from nearest city or town)

and is more particularly described as follows:

(a) S. 77° 45' E. 810 chains from NW corner S. 13, T. 10S, R. 3W.
(Give distance and bearing to corner of section or other legal subdivision)

being within NW¹ of NW¹ of Sec. 13, Twp. 10S, Rge. 4W
(Smallest legal subdivision) (N. or S.) (E. or W.)

or (b) within limits of recorded platted property, town or city:

in Lot _____, Block _____ of _____
(Name of plat or addition)

County of Linn
(If within city or town, give name)

3. Construction Work was begun on 1954; was completed on 1954
(Date) (Date)

and the ground water claimed was first used for the purposes set out below on 1954
(Date)

since which time the water has been used continuously
(Continuously or intermittently)

from 1954 to present time
(Date) (Date)

4. Quantity of water claimed and used is 225 gallons per minute; 52.0 acre feet per year.

5. Purpose or Purposes for which water is used Irrigation

(Domestic, irrigation, municipal, manufacturing, industrial, etc.)

6. Description of Well: Depth 42 feet. Type Drilled
(Dug or drilled)

diameter 10 inches. Elevation of ground at well site 130 feet, mean sea level.
(As near as known)

Depth to water table 18 feet.

7. Capacity of Well: _____ g.p.m. with _____ feet drawdown.

_____ g.p.m. with _____ feet drawdown.

Date of test Not tested

If Flowing Well: Measured discharge _____ g.p.m. on _____
(Date)

Shut-in pressure at ground surface _____ lbs. per sq. in. on _____
(Date)

Water is controlled by _____
(Cap, valve, etc.)

If log of well is not available, give name and address of driller. Nicholas Klaus, Route 4,

Albany, Oregon

11. Infiltration Trench: Covered or open

Dimensions: Length ft. Minimum depth ft. Maximum depth ft.

Bottom width ft. Discharge g.p.m. Date of test

12. Tunnel: Type of lining

Dimensions:
(Length, course, and cross sectional size)

Position of water bearing stratum with reference to portal of tunnel

Log of tunnel: (Preceding table for log of well may be used, if desired. Give footage from portal and character of materials, as pertinent.)

13. Pumping Equipment:

(a) Pump Fairbanks Morse 2 1/2" Cent. Capacity 225 g.p.m.
(Make, type and size)

(b) Motor 10 H.P. electric
(Type and horsepower)

14. Location of area irrigated or to be irrigated, or place of use if for purposes other than irrigation.

Township North or South	Range E. or W. of Willamette Meridian	Section	Forty-acre Tract	Number Acres To Be Irrigated	Date of Reclamation
10 S	4W	12	SW 1/4 of SW 1/4	2.5	1954
10 S	4W	13	NW 1/4 of NW 1/4	11.5	1954
				14.0	"


Charles W. Chambers

Beginning on the north line of and N.89°E. 37.07 chains from the Northwest corner of the Elias A. Johnson D.L.C. 74 in T. 10 S., R. 4 W. of the will. Mer. in Linn County, Oregon; and running thence South 4.00 chains to a 3/4" iron bolt; thence S.89°W. 97 links to a 1 1/2" iron pipe; thence South 17.11 chains to a 1/2" x 1 1/2" iron bar at the Southwest corner of that certain tract of land conveyed to Raymond K. and Elizabeth E. Baker by Deed recorded on page 734 of Vol 245 of Linn County Deed records; thence East along the South line of said Baker Street 10.606 chains; thence Northerly to a point on the North line of said Claim 74 and N.89°E. 4.545 chains from the place of beginning; thence S.89°E. 4.545 chains to the place of beginning and containing 16.52 acres, more or less, and subject to the rights of the public in the use of the county road.

15. If the ground water supply is supplemental to an existing water supply, identification of any application for a permit, permit, certificate or adjudicated right to appropriate water made or held by the registrant.

Township 10S Range 4N, W.M.

North

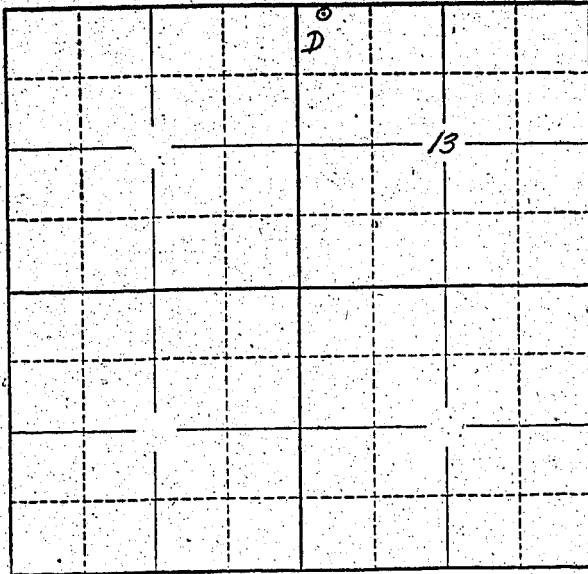

Locate well and acreage of irrigated land on plat.

Scale: 2" = 1 Mile

STATE OF OREGON

County of Linn } ss.

I, Charles W. and Patricia M. Chambers, being first duly sworn, do hereby certify that I have read the foregoing Registration Statement and that all of the items therein contained are true to the best of my knowledge and belief.

*Charles W. Chambers
Patricia M. Chambers*
(Signature of Registrant)

Subscribed and sworn to before me this 16 day of July, 1958

My commission expires October 1, 1960 *Lloyd G. Fisher*
(Notary Public)

(SEAL)

CERTIFICATE OF REGISTRATION

STATE OF OREGON

County of Marion } ss.

This is to certify that the foregoing Registration Statement was received in the office of the State Engineer on the 21 day of July, 1958, at 8:00 o'clock A.M. and has been duly recorded in said office in Book No. 10 of Registration Statements on page 2278

Witness my hand this 10th day of March, 19 59

Lewis G. Stanley
(State Engineer)

\$15.00

By _____ (Deputy)