

Registration Statement

OF CLAIMANT OF RIGHT TO APPROPRIATE GROUND WATER

TO THE STATE ENGINEER OF OREGON:

I, Edwin R. and Eva M. Smith

of Rt. 1, Shedd County of Linn

(Mailing address)

State of Oregon, do hereby make application for a certificate of registration as evidence of a right to appropriate ground water.

1. Source from which water is withdrawn is pump well
(Flowing well, pump well, infiltration trench, or tunnel)

2. Location is: 7 miles northwest of Shedd, Oregon
(Approximate distance and direction from nearest city or town)

and is more particularly described as follows:

(a) 70' S. and 924' E. of NW corner Sec. 5, T.13 S, R. 4 W.
(Give distance and bearing to corner of section or other legal subdivision)

being within NW 1/4 of NW 1/4 of Sec. 5, Twp. 13 S, Rge. 4 W
(Smallest legal subdivision) (N. or S.) (E. or W.)

or (b) within limits of recorded platted property, town or city:

in Lot _____, Block _____ of _____
(Name of plat or addition)

County of Linn
(If within city or town, give name)

3. Construction Work was begun on Dec. 1952; was completed on Jan. 1953
(Date) (Date)

and the ground water claimed was first used for the purposes set out below on June 1953
(Date)

since which time the water has been used continuously
(Continuously or intermittently)

from June 1953 to present time
(Date) (Date)

4. Quantity of water claimed and used is 90 gallons per minute; 30.0 acre feet per year.

5. Purpose or Purposes for which water is used Irrigation

(Domestic, irrigation, municipal, manufacturing, industrial, etc.)

6. Description of Well: Depth 75 feet. Type Drilled
(Dug or drilled)

diameter 12 inches. Elevation of ground at well site 220 feet, mean sea level.
(As near as known)

Depth to water table _____ feet.

7. Capacity of Well: 200 g.p.m. with 10 feet drawdown.

_____ g.p.m. with _____ feet drawdown.


Date of test _____

If Flowing Well: Measured discharge _____ g.p.m. on _____
(Date)

Shut-in pressure at ground surface _____ lbs. per sq. in. on _____
(Date)

Water is controlled by _____
(Cap, valve, etc.)

Township ~~13 S~~ 13 S Range ~~4 W~~ 4 W, W.M.
North

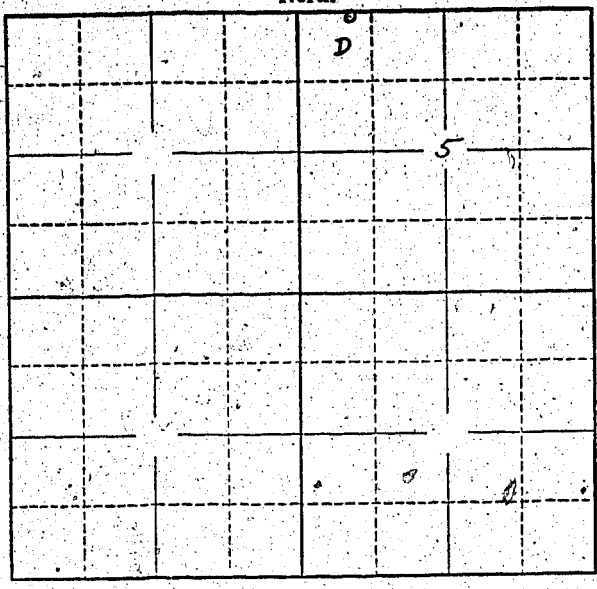

Locate well and acreage of irrigated land on plat.
Scale: 2" = 1 Mile

STATE OF OREGON }
County of CLATSOP BENTON } ss.

I, Edwin R. and Eva M. Smith, being first duly sworn, do hereby certify that I have read the foregoing Registration Statement and that all of the items therein contained are true to the best of my knowledge and belief.

Edwin R. Smith
Eva M. Smith
(Signature of Registrant)

Subscribed and sworn to before me this 16th day of July, 1958.

My commission expires Sept. 29, 1961

Reginald B. Blum
(Notary Public)

(SEAL)

CERTIFICATE OF REGISTRATION

STATE OF OREGON }
County of Marion } ss.

This is to certify that the foregoing Registration Statement was received in the office of the State Engineer on the 21 day of July, 1958, at 8:00 o'clock A. M. and has been duly recorded in said office in Book No. 10 of Registration Statements on page GR-2279

Witness my hand this 10th day of March, 1959.

Laura A. Stanley
(State Engineer)

\$15.00

By _____ (Deputy)