REGISTRATION NO. GR-2399

Registration Statement CERTIFICATE NO. GR-2280

OF CLAIMANT OF RIGHT TO APPROPRIATE GROUND WATER

(Under Chapter 708, Oregon Laws 1955.)

TO THE STATE ENGINEER OF OREGON:

I, Betty Lynd Thompson,

of Corvallis County of Benton

State of Oregon, do hereby make application for a certificate of registration as evidence of a right to appropriate ground water.

1. **Source** from which water is withdrawn is pump well
(Flowing well, pump well, infiltration trench, or tunnel)

2. **Location** is: 3½ miles SW Corvallis
(Approximate distance and direction from nearest city or town);

and is more particularly described as follows:

(a) 990' S 77° E of NW corner of Sec. 8
(Give distance and bearing to corner of section or other legal subdivision)

being within NW¼ of NW¼ (Smallest legal subdivision) of Sec. 8, Twp. 12S (N. or S.), Rge. 5 W (E. or W.)

or (b) within limits of recorded platted property, town or city:

in Lot ....., Block ..... of ..... (Name of plat or addition)

..... (If within city or town, give name) County of Benton

3. **Construction Work** was begun on prior to 1950 (Date); was completed on May, 1951 (Date)

and the ground water claimed was first used for the purposes set out below on May, 1951 (Date),

since which time the water has been used continuously (Continuously or intermittently)

from May, 1951 (Date) to present (Date)

4. **Quantity** of water claimed and used is 10 gallons per minute; 4 acre feet per year.

5. **Purpose or Purposes** for which water is used

~~domestic and~~ irrigation
(Domestic, irrigation, municipal, manufacturing, industrial, etc.)

6. **Description of Well:** Depth ± 90 feet. Type drilled (Dug or drilled)

diameter 8 inches. Elevation of ground at well site 260 (As near as known) feet, mean sea level.

Depth to water table 60 feet.

7. **Capacity of Well:** 10 g.p.m. with 10' feet drawdown.

..... g.p.m. with ..... feet drawdown.

Date of test 1956 capacity

If Flowing Well: Measured discharge ..... g.p.m. on ..... (Date)

Shut-in pressure at ground surface ..... lbs. per sq. in. on ..... (Date)

Water is controlled by ..... (Cap, valve, etc.)

8. **Casing:** (Give diameter, commercial specifications and depth below ground surface of each casing size.)

8" inch diameter steel from surface to 50 plus feet

..... inch diameter ..... from ..... to ..... feet

..... inch diameter ..... from ..... to ..... feet

..... inch diameter ..... from ..... to ..... feet

Describe and show depth of shoe, plug, adapter, liner or other details:

unknown

9. **Perforated Casings or Screens:**

none from ..... to .....
(Number per foot and size of perforations, or describe screen)

..... from ..... to .....

..... from ..... to .....

..... from ..... to .....

10. **Log of Well:** (Describe each stratum or formation clearly, indicate if water bearing, and give thickness and depth as indicated.)

MATERIAL	Thickness (Feet)	Depth to Bottom (Feet)
unknown		

GR-2280

If log of well is not available, give name and address of driller. Frank Skillings

Route 1, Corvallis

11. **Infiltration Trench:** Covered or open .....

Dimensions: Length ..... ft. Minimum depth ..... ft. Maximum depth ..... ft.

Bottom width ..... ft. Discharge ..... g.p.m. Date of test .....

12. **Tunnel:** Type of lining .....

Dimensions: .....
(Length, course, and cross sectional size)

Position of water bearing stratum with reference to portal of tunnel .....

Log of tunnel: (Preceding table for log of well may be used, if desired. Give footage from portal and character of materials, as pertinent.)

13. **Pumping Equipment:**

(a) Pump crane jet model 2320 (Make, type and size) Capacity 25 g.p.m.

(b) Motor 2 h.p. 3 ~~phase~~ phase (Type and horsepower)

14. Location of area irrigated or to be irrigated, or place of use if for purposes other than irrigation.

Township North or South	Range E. or W. of Willamette Meridian	Section	Forty-acre Tract	Number Acres To Be Irrigated	Date of Reclamation
12 S	5 W	8	NW¼ of NW¼	2.0	1951

15. If the ground water supply is supplemental to an existing water supply, identification of any application for a permit, permit, certificate or adjudicated right to appropriate water made or held by the registrant.

.....

GR- 2280

See map attached.

Township 12S Range 5W, W.M.

North

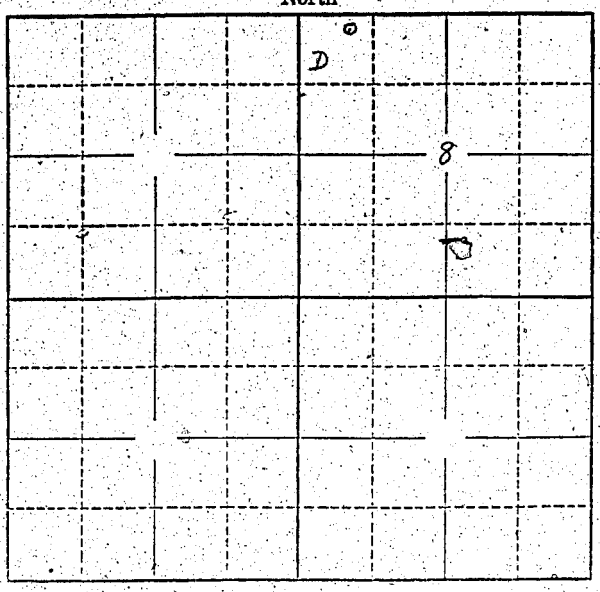

Locate well and acreage of irrigated land on plat.

Scale: 2" = 1 Mile

STATE OF OREGON
County of Benton } ss.

I, Betty Lynd Thompson, being first duly sworn, do hereby certify that I have read the foregoing Registration Statement and that all of the items therein contained are true to the best of my knowledge and belief.

Betty Lynd Thompson
(Signature of Registrant)

Subscribed and sworn to before me this 22nd day of January, 19 57

My commission expires April 4, 1958

L. Laune Rickbaugh
(Notary Public)

(SEAL)

CERTIFICATE OF REGISTRATION

STATE OF OREGON
County of Marion } ss.

This is to certify that the foregoing Registration Statement was received in the office of the State Engineer on the 21 day of July, 19 58, at 8:00 o'clock A M. and has been duly recorded in said office in Book No. 10 of Registration Statements on page GR-2280

~~Certificate shall be completed by ..... if ..... and the water completely applied to beneficial use by ..... 19 .....~~

Witness my hand this 10th day of March, 19 59

Kenneth H. Tiedman
(State Engineer)

$15.00

By .....
(Deputy)

GR-2280