

Registration Statement

OF CLAIMANT OF RIGHT TO APPROPRIATE GROUND WATER

TO THE STATE ENGINEER OF OREGON:

I, Philip J. and Della M. Eraden

of Route 3, Box 88, Scio County of Linn
(Mailing address)

State of Oregon, do hereby make application for a certificate of registration as evidence of a right to appropriate ground water.

1. Source from which water is withdrawn is Pump well
(Flowing well, pump well, infiltration trench, or tunnel)

2. Location is: 2 1/2 miles NW of Crabtree, Oregon
(Approximate distance and direction from nearest city or town)

and is more particularly described as follows:

(a) 726' N and 1551' W. of SE corner of NE 1/4 of S. 33, T. 10S., R. 2W.
(Give distance and bearing to corner of section or other legal subdivision)

being within SW 1/4 of NE 1/4 of Sec. 33, Twp. 10 S., Rge. 2 W.
(Smallest legal subdivision) (N. or S.) (E. or W.)

or (b) within limits of recorded platted property, town or city:

in Lot _____, Block _____ of _____
(Name of plat or addition)

County of Linn
(If within city or town, give name)

3. Construction Work was begun on 1948; was completed on 1948
(Date) (Date)

and the ground water claimed was first used for the purposes set out below on 1948
(Date)

since which time the water has been used Continuously
(Continuously or intermittently)

from 1948 to 1956
(Date) (Date)

4. Quantity of water claimed and used is 150 gallons per minute; 930 acre feet per year.

5. Purpose or Purposes for which water is used Irrigation

(Domestic, irrigation, municipal, manufacturing, industrial, etc.)

6. Description of Well: Depth 28 feet. Type Drilled
(Dug or drilled)

diameter 10 inches. Elevation of ground at well site 240 feet, mean sea level.
(As near as known)

Depth to water table 10 feet.

7. Capacity of Well: 150 g.p.m. with 18 feet drawdown.

_____ g.p.m. with _____ feet drawdown.

Date of test 1948


If Flowing Well: Measured discharge _____ g.p.m. on _____
(Date)

Shut-in pressure at ground surface _____ lbs. per sq. in. on _____
(Date)

Water is controlled by _____
(Cap, valve, etc.)

Township 10S. Range 2 W. W.M.

North

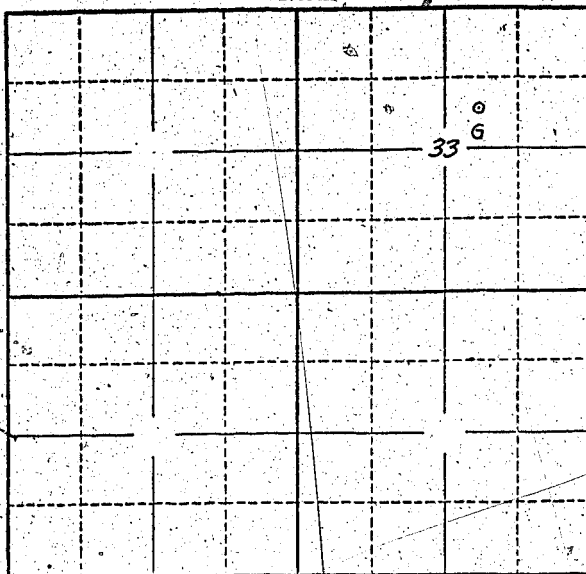

Locate well and acreage of irrigated land on plat.

Scale: 2" = 1 Mile

STATE OF OREGON

County of Linn

ss.

I, Philip J. and Della M. Braden, being first duly sworn, do hereby certify that I have read the foregoing Registration Statement and that all of the items therein contained are true to the best of my knowledge and belief.

Philip J. Braden Della M. Braden (Signature of Registrant)

Subscribed and sworn to before me this 18th day of July, 1958

My commission expires

(Notary Public)

(SEAL)

CERTIFICATE OF REGISTRATION

STATE OF OREGON

County of Marion

ss.

This is to certify that the foregoing Registration Statement was received in the office of the State Engineer on the 21st day of July, 1958, at 8:00 o'clock A.M. and has been duly recorded in said office in Book No. 10 of Registration Statements on page GR-2282

Witness my hand this 10th day of March, 1959

Lewis A. Stanley (State Engineer)

By

(Deputy)

GR - 2282

4/15/58