

# Registration Statement

## OF CLAIMANT OF RIGHT TO APPROPRIATE GROUND WATER

TO THE STATE ENGINEER OF OREGON:

I, Chester Roche

of Route 1, Box 425, Corvallis County of Benton

State of Oregon, do hereby make application for a certificate of registration as evidence of a right to appropriate ground water.

1. Source from which water is withdrawn is pump well  
(Flowing well, pump well, infiltration trench, or tunnel)

2. Location is: 1 mile east of Corvallis  
(Approximate distance and direction from nearest city or town)

and is more particularly described as follows: N 31° 30' E 2178' to reference point, said point

(a) being 7.73 chains E 3.0 chains N of the common corner of  
(Give distance and bearing to corner of section or other legal subdivision)

well being within SE 1/4 NE 1/4 S. 2 of Sec. 1, 2, 3, 35, 36, Twp. 11 & 12, Rge. 5W, M.M.  
(Smallest legal subdivision) (N. or S.) (E. or W.)

or (b) within limits of recorded platted property, town or city:

in Lot \_\_\_\_\_, Block \_\_\_\_\_ of \_\_\_\_\_  
(Name of plat or addition)

County of \_\_\_\_\_  
(If within city or town, give name)

3. Construction Work was begun on 1939; was completed on 1939  
(Date) (Date)

and the ground water claimed was first used for the purposes set out below on 1939  
(Date)

since which time the water has been used intermittently  
(Continuously or intermittently)

from 1939 to 1958  
(Date) (Date)

4. Quantity of water claimed and used is 800 when pumping gallons per minute; 200 acre feet per year.

5. Purpose or Purposes for which water is used irrigation

(Domestic, irrigation, municipal, manufacturing, industrial, etc.)

6. Description of Well: Depth 30 feet. Type drilled  
(Dug or drilled)

diameter 10 inches. Elevation of ground at well site 220 feet, mean sea level.  
(As near as known)

Depth to water table 12 feet.

7. Capacity of Well: 800 g.p.m. with 1 feet drawdown.

\_\_\_\_\_ g.p.m. with \_\_\_\_\_ feet drawdown.

Date of test 1939

If Flowing Well: Measured discharge \_\_\_\_\_ g.p.m. on \_\_\_\_\_  
(Date)


Shut-in pressure at ground surface \_\_\_\_\_ lbs. per sq. in. on \_\_\_\_\_  
(Date)

Water is controlled by \_\_\_\_\_  
(Cap, valve, etc.)





Township 12 S Range 5 W, W.M.  
North

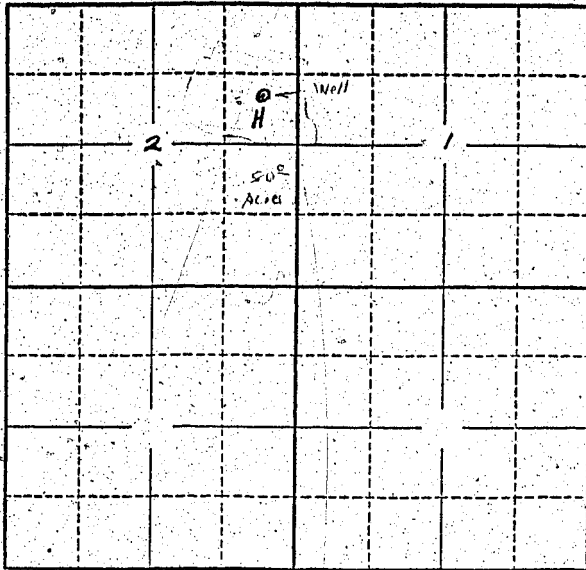

Locate well and acreage of irrigated land on plat.  
Scale: 2" = 1 Mile

STATE OF OREGON  
County of BENTON

} ss.

I, CHESTER ROCHE, being first duly sworn, do hereby certify that I have read the foregoing Registration Statement and that all of the items therein contained are true to the best of my knowledge and belief.

*Chester Roche*  
(Signature of Registrant)

Subscribed and sworn to before me this 19th day of July, 1958

My commission expires Feb. 14, 1961 F. J. Bailey  
(Notary Public)

(SEAL)

### CERTIFICATE OF REGISTRATION

STATE OF OREGON }  
County of Marion } ss.

This is to certify that the foregoing Registration Statement was received in the office of the State Engineer on the 21 day of July, 1958, at 8:00 o'clock A.M. and has been duly recorded in said office in Book No. 10 of Registration Statements on page GR 2285

Witness my hand this 10th day of March, 1959

*Lewis A. Stanley*  
(State Engineer)

By \_\_\_\_\_  
(Deputy)

\$22.50