

Registration Statement

OF CLAIMANT OF RIGHT TO APPROPRIATE GROUND WATER

TO THE STATE ENGINEER OF OREGON:

I, Robert V. Cox

of Rt. 2, Box 255, Lebanon
(Mailing address)

County of Linn

State of Oregon do hereby make application for a certificate of registration as evidence of a right to appropriate ground water.

1. Source from which water is withdrawn is pump well
(Flowing well, pump well, infiltration trench, or tunnel)

2. Location is: 6 miles NW of Lebanon, Oregon
(Approximate distance and direction from nearest city or town)

and is more particularly described as follows:

(a) 891' south and 1122' W. of NE corner of S. 30, T. 11 S, R. 2 W.
(Give distance and bearing to corner of section or other legal subdivision)

being within NE¹ of NE¹ of Sec. 30, Twp. 11 S, Rge. 2 W
(Smallest legal subdivision) (N. or S.) (E. or W.)

or (b) within limits of recorded platted property, town or city:

in Lot _____, Block _____ of _____
(Name of plat or addition)

(If within city or town, give name) County of Linn

3. Construction Work was begun on 1953; was completed on 1953
(Date) (Date)

and the ground water claimed was first used for the purposes set out below on 1953
(Date)

since which time the water has been used continuously
(Continuously or intermittently)

from 1953 to present time
(Date) (Date)

4. Quantity of water claimed and used is 180 gallons per minute; 150.0 acre feet per year.

5. Purpose or Purposes for which water is used Irrigation

(Domestic, irrigation, municipal, manufacturing, industrial, etc.)

6. Description of Well: Depth 138 feet. Type Drilled
(Dug or drilled)

diameter 8 inches. Elevation of ground at well site 250 feet, mean sea level.
(As near as known)

Depth to water table 8 feet.

7. Capacity of Well: 200 g.p.m. with 100 feet drawdown.

_____ g.p.m. with _____ feet drawdown.


Date of test 1957

If Flowing Well: Measured discharge _____ g.p.m. on _____
(Date)

Shut-in pressure at ground surface _____ lbs. per sq. in. on _____
(Date)

Water is controlled by _____
(Cap, valve, etc.)

Township 11 S Range 2 W, W.M.
North

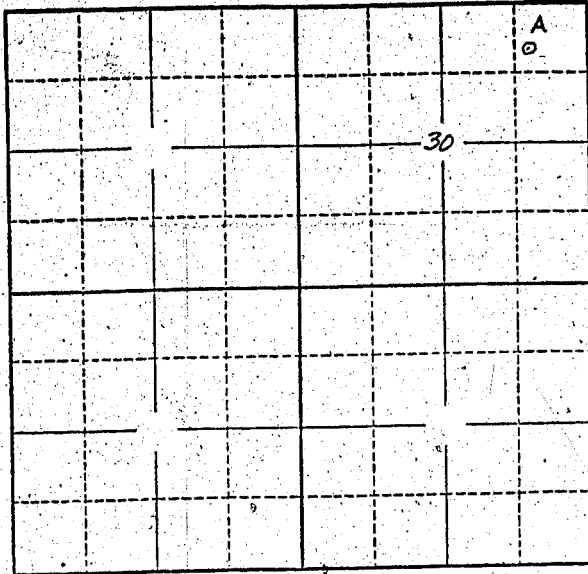

Locate well and acreage of irrigated land on plat.
Scale: 2" = 1 Mile

STATE OF OREGON }
County of LINN } ss.

I, Robert V. Cox being first duly sworn, do hereby certify that I have read the foregoing Registration Statement and that all of the items therein contained are true to the best of my knowledge and belief.

Subscribed and sworn to before me this 18th day of July, 1958
My commission expires 8/15/59
Howard Carpenter
(Notary Public)

(SEAL)

CERTIFICATE OF REGISTRATION

STATE OF OREGON }
County of Marion } ss.

This is to certify that the foregoing Registration Statement was received in the office of the State Engineer on the 21st day of July, 1958, at 9:00 o'clock A.M. and has been duly recorded in said office in Book No. 10 of Registration Statements on page GR 2287

Witness my hand this 10th day of March, 1959
Laura A. Stanley
(State Engineer)

\$ 18.00

By _____ (Deputy)