

RECEIVED

AUG 24 1956

STATE ENGINEER
SALEM, OREGON

Registration Statement

REGISTRATION NO. GR-241

CERTIFICATE NO. GR-218

OF CLAIMANT OF RIGHT TO APPROPRIATE GROUND WATER

(Under Chapter 708, Oregon Laws 1955.)

TO THE STATE ENGINEER OF OREGON:

I, Lester W. Ernst and Kathryn Ernst

of St. Paul County of Marion

State of Oregon, do hereby make application for a certificate of registration as evidence of a right to appropriate ground water.

1. Source from which water is withdrawn is Pump well # /
(Flowing well, pump well, infiltration trench, or tunnel)

2. Location is: in City limits of St. Paul, Oregon
(Approximate distance and direction from nearest city or town)

and is more particularly described as follows:

Beginning at iron pipe in center of intersection of Main St. and Blanchette Ave. then Easterly down center of Blanchette Ave. 148 ft., then Southerly from center of Blanchette Ave. 49 ft., to well

being within SE 1/4 of NE 1/4 of Sec. 19, Twp. 4S, Rge. 2 W
(Smallest legal subdivision) (N. or S.) (E. or W.)

or (b) within limits of recorded platted property, town or city:

in Lot 1, Block 37 of _____
(Name of plat or addition)

St. Paul County of Marion
(If within city or town, give name)

3. Construction Work was begun on 1916; was completed on 1916
(Date) (Date)

and the ground water claimed was first used for the purposes set out below on 1916
(Date)

since which time the water has been used continuously
(Continuously or intermittently)

from 1916 to date
(Date) (Date)

4. Quantity of water claimed and used is 110 gallons per minute; _____ acre feet per year.

5. Purpose or Purposes for which water is used City of St. Paul, Oregon water supply municipal
(Domestic, irrigation, municipal, manufacturing, industrial, etc.)

6. Location of Well: Depth 170 feet. Type drilled
(Dug or drilled)
diameter _____ inches. Elevation of ground at well site 167 feet, mean sea level.
(As near as known)

Depth to water 39 feet.

7. Capacity of Well: 110 g.p.m. with 60 feet drawdown.
_____ g.p.m. with _____ feet drawdown.

Date of test no test

If Flowing Well: Measured discharge _____ g.p.m. on _____
(Date)

Shut-in pressure at ground surface _____ lbs. per sq. in. on _____
(Date)

Water is controlled by _____
(Cap, valve, etc.)

If log of well is not available, give name and address of driller:

11. Infiltration Trench: Covered or open

Dimensions: Length ft. Minimum depth ft. Maximum depth ft.

Bottom width ft. Discharge g.p.m. Date of test

12. Tunnel: Type of lining

Dimensions:
(Length, course, and cross-sectional size)

Position of water bearing stratum with reference to portal of tunnel

Log of tunnel: (Preceding table for log of well may be used, if desired. Give footage from portal and character of materials, as pertinent.)

13. Pumping Equipment:

(a) Pump 1 Pamona deep well Turbine Capacity 110 g.p.m.
(Make, type and size)


(b) Motor 5 HP 3 phase vertical hallow shaft
(Type and horsepower)

14. Location of area irrigated or to be irrigated, or place of use if for purposes other than irrigation.

Township North or South	Range E. or W. of Willamette Meridian	Section	Forty-acre Tract	Number Acres To Be Irrigated	Date of Reclamation
T4S	R2W	18	SE $\frac{1}{4}$ of SW $\frac{1}{4}$	Municipal	1916
		18	SW $\frac{1}{4}$ of SE $\frac{1}{4}$	"	"
		19	NE $\frac{1}{4}$ of NW $\frac{1}{4}$	"	"
		19	NW $\frac{1}{4}$ of NE $\frac{1}{4}$	"	"
		19	NE $\frac{1}{4}$ of NE $\frac{1}{4}$	"	"
		19	SE $\frac{1}{4}$ of NW $\frac{1}{4}$	"	"
		19	SW $\frac{1}{4}$ of NE $\frac{1}{4}$	"	"
		19	SE $\frac{1}{4}$ of NE $\frac{1}{4}$	"	"
		19	NW $\frac{1}{4}$ of SE $\frac{1}{4}$	"	"

15. If the land and water supply is supplemental to an existing water supply, identification of any application for a permit, permit, certificate or adjudicated right to appropriate water made or held by the registrant.

Township 4 S Range 2 W W.M.
North

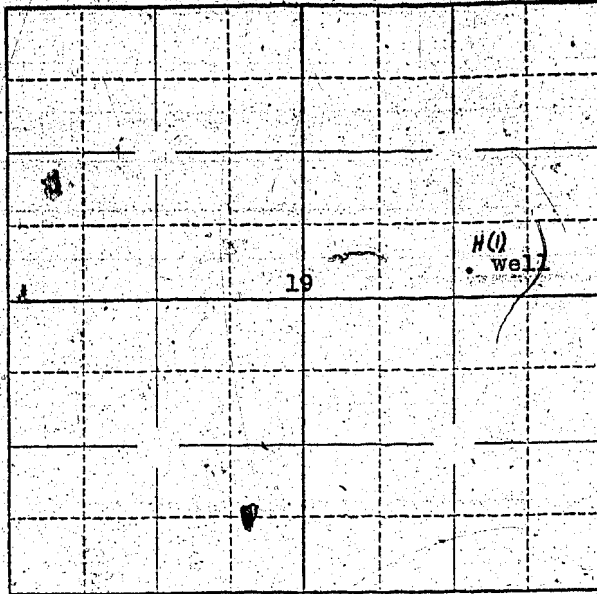

Locate well and acreage of irrigated land on plat.
Scale: 2" = 1 Mile

STATE OF OREGON }
County of Marion } ss.

I, Lester Ernst, being first duly sworn, do hereby certify that I have read the foregoing Registration Statement and that all of the items therein contained are true to the best of my knowledge and belief.

Lester Ernst
(Signature of Registrant)

Subscribed and sworn to before me this 22 day of August, 1956

Alfred E. Smith
(Notary Public)

My commission expires April 29, 1960

(SEAL)

SEE PAGE GR-218 G FOR
CERTIFICATE OF REGISTRATION

STATE OF OREGON }
County of Marion } ss.

This is to certify that the foregoing Registration Statement was received in the office of the State Engineer on the X-X-X day of X-X-X-X-X-X-X-X-X-X 19 X-X-X-X-X-X o'clock X-X-X-X and has been duly recorded in said office in Book No. X-X-X-X-X-X of Registration Statements on page X-X-X-X-X-X.

Construction which is completed by X-X-X-X-X-X-X-X-X-X and the water completely applied to beneficial use by X-X-X-X-X-X-X-X-X-X 19 X-X-X-X.

Witness my hand this 23rd day of November, 1956.

.....
(State Engineer)
By
(Deputy)

GR-218C

RECEIVED
AUG 24 1956
STATE ENGINEER
SALEM, OREGON

REGISTRATION NO. GR-241
CERTIFICATE NO. GR-218

Registration Statement

OF CLAIMANT OF RIGHT TO APPROPRIATE GROUND WATER

(Under Chapter 703, Oregon Laws 1955.)

TO THE STATE ENGINEER OF OREGON:

I, Lester W. Ernst and Kathryn Ernst

of St. Paul County of Marion

State of Oregon do hereby make application for a certificate of registration as evidence of a right to appropriate ground water.

1. Source from which water is withdrawn is Pump well #2
(Flowing well, pump well, infiltration trench, or tunnel)
2. Location is: in City limits of St. Paul, Oregon
(Approximate distance and direction from nearest city or town)

and is more particularly described as follows:

Beginning at iron rod in center of intersection of Christie and
 (a) Blanchette Ave. then Westerly down center of St. Paul, Horseshoe Lake
Road 855 ft. then Southerly from center of road 166 ft. to well,
 being within S.W. 1/4 of the N.E. 1/4 of Sec. 18, Twp. 4 S, Rge. 2 W, W.M.
(Give distance and bearing to corner of section or other legal subdivision)
(Smallest legal subdivision) (N. or S.) (E. or W.)

or (b) within limits of recorded platted property, town or city: St. Paul, Oregon

in Lot _____, Block _____ of _____
(Name of plat or addition)
St. Paul County of Marion
(If within city or town, give name)

3. Construction Work was begun on April 20, 1952; was completed on May 12, 1952
(Date) (Date)

and the ground water claimed was first used for the purposes set out below on June 2, 1952
(Date)
since which time the water has been used continuously
(Continuously or Intermittently)
from June 2, 1952 to date
(Date) (Date)

4. Quantity of water claimed and used is 185 gallons per minute; _____ acre feet per year.

5. Purpose or Purposes for which water is used City of St. Paul, Oregon water supply
Municipal
(Domestic, irrigation, municipal, manufacturing, industrial, etc.)

6. Description of Well: Depth 125 feet. Type drilled
(Dug or drilled)
diameter 8 inches. Elevation of ground at well site 167 feet, mean sea level.
(As near as known)
Depth to water table 38 feet.

7. Capacity of Well: 350 g.p.m. with 85 feet drawdown.
_____ g.p.m. with _____ feet drawdown.

Date of test May 12, 1952

If Flowing Well: Measured discharge _____ g.p.m. on _____
(Date)

Shut-in pressure at ground surface _____ lbs. per sq. in. on _____
(Date)

Water is controlled by _____
(Ccp. valve, etc.)

GR-218.D

8. **Casing:** (Give diameter, commercial specifications and depth below ground surface of each casing size.)

8 inch diameter steel wall casing from 0 to 123 feet
 inch diameter from to feet
 inch diameter from to feet
 inch diameter from to feet

Describe and show depth of shoe, plug, adapter, liner or other details: no shoe

9. **Perforated Casings or Screens:**

none from to
(Number per foot and size of perforations, or describe screen)
 from to
 from to
 from to

10. **Log of Well:** (Describe each stratum or formation clearly, indicate if water bearing, and give thickness and depth as indicated.)

Well drilled by J. T. Miller, Auoroa, Oregon P. O. Box 198

MATERIAL	Thickness (Feet)	Depth to Bottom (Feet)
0-62 surface and clay		
62-98 muddy sand black		
98-104 grey clay		
104-118 green clay		
118-123 soft clay and some sand making some water,		
123-125 black sand and small gravel		

If log of well is not available, give name and address of driller.

11. Infiltration Trench: Covered or open

Dimensions: Length ft. Minimum depth ft. Maximum depth ft.

Bottom width ft. Discharge g.p.m. Date of test

12. Tunnel: Type of lining

Dimensions:
(Length, course, and cross sectional size)

Position of water bearing stratum with reference to portal of tunnel

Log of tunnel: (Preceding table for log of well may be used, if desired. Give footage from portal and character of materials, as pertinent.)

13. Pumping Equipment:

(a) Pump Peerless deep well Turbine Capacity 185 g.p.m.
(Make, type and size)


(b) Motor 10 HP 3 phase vertical hallow shaft
(Type and horsepower)

14. Location of area irrigated or to be irrigated, or place of use if for purposes other than irrigation.

Township North or South	Range E. or W. of Willamette Meridian	Section	Forty-acre Tract	Number Acres To Be Irrigated	Date of Reclamation
T4S	R2W	18	SE 1/4 of SW 1/4	Municipal	1952
"	"	18	SW 1/4 of SE 1/4	"	"
"	"	19	NE 1/4 of NW 1/4	"	"
"	"	19	NW 1/4 of NE 1/4	"	"
"	"	19	NE 1/4 of NE 1/4	"	"
"	"	19	SE 1/4 of NW 1/4	"	"
"	"	19	SW 1/4 of NE 1/4	"	"
"	"	19	SE 1/4 of NE 1/4	"	"
"	"	19	NW 1/4 of SE 1/4	"	"

15. If the ground water supply is supplemental to an existing water supply, identification of any application for a permit, permit, certificate or adjudicated right to appropriate water made or held by the registrant.

Township 4 S Range 2 W W.M.
North

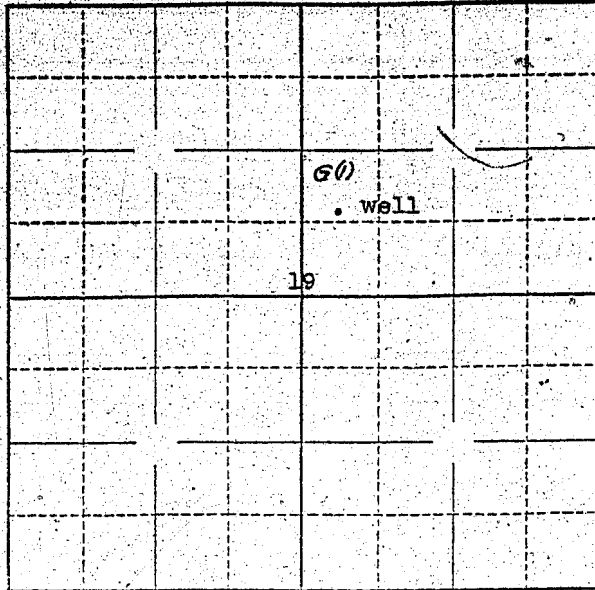

Locate well and acreage of irrigated land on plat.

Scale: 2" = 1 Mile

STATE OF OREGON

County of Marion ss.

I, Lester Ernst, being first duly sworn, do hereby certify that I have read the foregoing Registration Statement and that all of the items therein contained are true to the best of my knowledge and belief.

Lester Ernst
(Signature of Registrant)

Subscribed and sworn to before me this 22 day of August, 19 56.

My commission expires April 29, 1960

Alfred E. Smith
(Notary Public)

(SEAL)

CERTIFICATE OF REGISTRATION

STATE OF OREGON

County of Marion ss.

This is to certify that the foregoing Registration Statement was received in the office of the State Engineer on the 24th day of August, 19 56, at 10 o'clock A.M. and has been duly recorded in said office in Book No. 2 of Registration Statements on page GR-218 G.

~~Construction shall be completed by X-X-X-X-X-X-X-X-X-X-10-X-X and the water completely applied to beneficial use by X-X-X-X-X-X-X-X-X-X-12-X-X.~~

Witness my hand this 23rd day of November.

19 56
Levin A. Dunsley
(State Engineer)

By

(Deputy)

GR-218 G