

Registration Statement

OF CLAIMANT OF RIGHT TO APPROPRIATE GROUND WATER (Under Chapter 708, Oregon Laws 1955.)

TO THE STATE ENGINEER OF OREGON:

I, Lynn Averill, Attorney in fact for Martha J. Averill
of Corvallis County of Benton
State of Oregon, do hereby make application for a certificate of registration as evidence
of a right to appropriate ground water.

- 1. Source from which water is withdrawn is pump well #3
(Flowing well, pump well, infiltration trench, or tunnel)
- 2. Location is: 1 E 1/2 N Corvallis
(Approximate distance and direction from nearest city or town)

and is more particularly described as follows:

(a) 3300' N, 140' W of N.W. Cor. Pleasant Robinette D.L.C.
(Give distance and bearing to corner of section or other legal subdivision)
being within SW of NE4 of Sec. 36, Twp. 11S, Rge. 5W
(Smallest legal subdivision) (N. or S.) (E. or W.)

or (b) within limits of recorded platted property, town or city:
in Lot _____, Block _____ of _____
(Name of plat or addition)
County of _____
(If within city or town, give name)

3. Construction Work was begun on _____; was completed on June 1939
(Date) (Date)

and the ground water claimed was first used for the purposes set out below on 1939
(Date)
since which time the water has been used continuously
(Continuously or intermittently)
from 1939 to present
(Date) (Date)

4. Quantity of water claimed and used is 200 gallons per minute; 75 acre
feet per year.

5. Purpose or Purposes for which water is used _____
irrigation for agricultural research
(Domestic, irrigation, municipal, manufacturing, industrial, etc.)

6. Description of Well: Depth 35 feet. Type drilled
(Dug or drilled)
diameter 10 inches. Elevation of ground at well site 220 feet, mean sea level.
(As near as known)
Depth to water table 17 feet.

7. Capacity of Well: 300 g.p.m. with 10 approx feet drawdown.
_____ g.p.m. with _____ feet drawdown.
Date of test Unknown


If Flowing Well: Measured discharge _____ g.p.m. on _____
(Date)

Shut-in pressure at ground surface _____ lbs. per sq. in. on _____
(Date)

Water is controlled by _____
(Cap, valve, etc.)

Township 11S Range 5W, W.M.

North

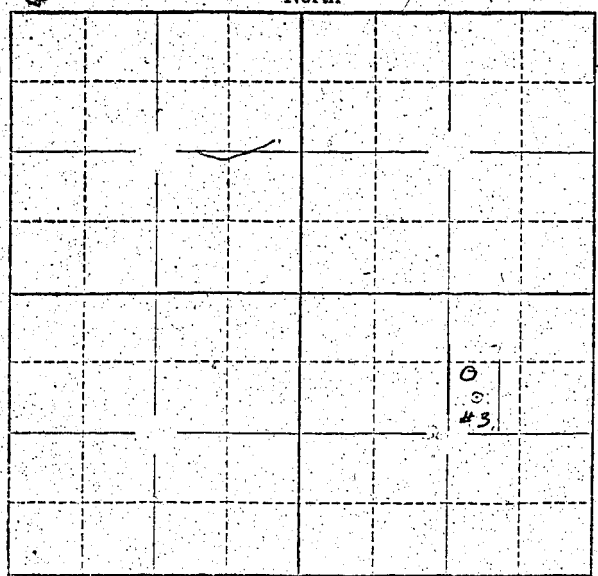

Locate well and acreage of irrigated land on plat.
Scale: 2" = 1 Mile

STATE OF OREGON

County of Benton } ss.

I, Luiss Averill attorney in fact for Martha J. Averill, being first duly sworn, do hereby certify that I have read the foregoing Registration Statement and that all of the items therein contained are true to the best of my knowledge and belief.

Luiss Averill
Signature of Registrant
15th day of July, 1958

Subscribed and sworn to before me this _____ day of _____, 1958

My commission expires 4 Nov 1960

WT Lemmon
(Notary Public)

(SEAL)

CERTIFICATE OF REGISTRATION

STATE OF OREGON

County of Marion } ss.

This is to certify that the foregoing Registration Statement was received in the office of the State Engineer on the 21 day of July, 1958, at 8:00 o'clock A. M. and has been duly recorded in said office in Book No. 10 of Registration Statements on page GR-2293

~~Construction shall be completed by _____ 19____ and the state map shall be completed by _____ 19____.~~

Witness my hand this 10th day of March, 1959

(State Engineer)

By _____ (Deputy)

#1500

GR-2293