

Registration Statement

REGISTRATION NO. GR-2417

CERTIFICATE NO. GR-2297

OF CLAIMANT OF RIGHT TO APPROPRIATE GROUND WATER

(Under Chapter 708, Oregon Laws 1955.)

TO THE STATE ENGINEER OF OREGON:

I, William Wallace Graham

Rt 2 - Box 143

of Salem, Oregon.

County of Marion

State of Oregon.

do hereby make application for a certificate of registration as evidence of a right to appropriate ground water.

1. Source from which water is withdrawn is Pump well

(Flowing well, pump well, infiltration trench, or tunnel)

2. Location is: Approx. eight miles N. of Salem near Clear Lake. Part of the

(Approximate distance and direction from nearest city or town)

and is more particularly described as follows: south end of the ranch borders Clear lake itself and runs North to the county road.

(a) 2 Ch. E of 14 Chaining N from SW Corner Sec. 14

(Give distance and bearing to corner of section or other legal subdivision)

being within SW 1/4 SW 1/4

(Smallest legal subdivision)

of Sec. 14

Twp. 6S

(N. or S.)

Rge. 3W

(E. or W.)

or (b) within limits of recorded platted property, town or city:

in Lot _____, Block _____ of _____

(Name of plat or addition)

County of Marion county

(If within city or town, give name)

3. Construction Work was begun on April or May

(Date)

was completed on same month 1945

(Date)

and the ground water claimed was first used for the purposes set out below on same month 1945

(Date)

since which time the water has been used during April thru 15th August usually

(Continuously or intermittently)

from April to thru August 15th - depending on weather conditions of the year of course.

(Date)

(Date)

4. Quantity of water claimed and used is 600 gallons per minute; _____ acre feet per year. actual capacity of well unknown. We have pumped the above day and night for two weeks. Well dropped about one foot in first hour. Then no more.

5. Purpose or Purposes for which water is used Irrigation - in the past and at present for growing Hops.

(Domestic, irrigation, municipal, manufacturing, industrial, etc.)

6. Description of Well: Depth 35 feet. Type drilled

(Dug or drilled)

diameter 10 inches. Elevation of ground at well site approx. 40 ft. (?) feet, mean sea level.

(As near as known)

Depth to water table approx. 16 feet.

7. Capacity of Well: unknown g.p.m. with 1 ft. feet drawdown.

g.p.m. with _____ feet drawdown.

Date of test 1945 - but actual capacity unknown.

If Flowing Well: Measured discharge _____ g.p.m. on _____

(Date)


Shut in pressure at ground surface _____ lbs. per sq. in. on _____

(Date)

Water is controlled by _____

(Cap, valve, etc.)

Township 6S Range 3W, W.M.
North

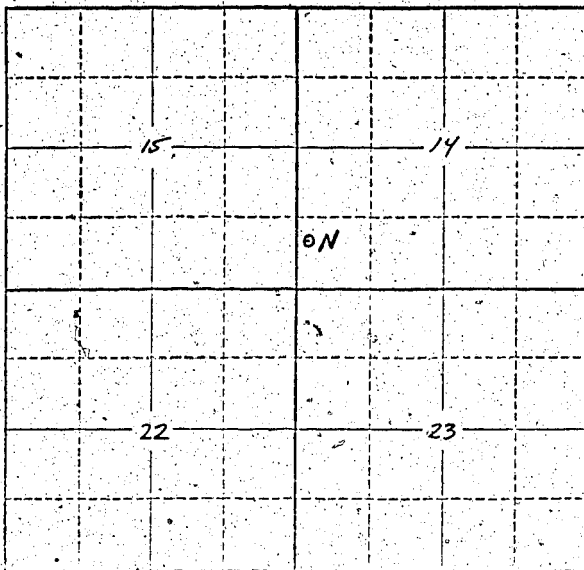

Locate well and acreage of irrigated land on plat.
Scale: 2" = 1 Mile

STATE OF OREGON

County of Marion

ss.

I, William Wallace Schay, being first duly sworn, do hereby certify that I have read the foregoing Registration Statement and that all of the items therein contained are true to the best of my knowledge and belief.

William Wallace Schay
(Signature of Registrant)

Subscribed and sworn to before me this 21st day of July, 1958

My commission expires Sept 8, 1960

Chas. H. Schale
(Notary Public)

(SEAL)

CERTIFICATE OF REGISTRATION

STATE OF OREGON

County of Marion

ss.

This is to certify that the foregoing Registration Statement was received in the office of the State Engineer of the 21st day of July, 1958, at 9⁰⁰ o'clock A.M. and has been duly recorded in said office in Book No. 10 of Registration Statements on page GR-2297

Witness my hand this 10th day of March, 1959

W. A. Schay
(State Engineer)

\$ 26.40

By

GR-2297

(Deputy)