

Registration Statement

OF CLAIMANT OF RIGHT TO APPROPRIATE GROUND WATER

TO THE STATE ENGINEER OF OREGON:

I, William Walter Poole

of Acornville R1 Box 126 County of Marion

State of Oregon, do hereby make application for a certificate of registration as evidence of a right to appropriate ground water.

1. Source from which water is withdrawn is Flowing well
(Flowing well, pump well, infiltration trench, or tunnel)

2. Location is: Four miles west Dayton on Marion Road
(Approximate distance and direction from nearest city or town)

and is more particularly described as follows:

(a) N 26° 15' W - 80.0 from SW corner DLC 39
(Give distance and bearing to corner of section or other legal subdivision)

being within NW 1/4 SE 1/4 of Sec. 24, Twp. 9S, Rge. 2W
(Smallest legal subdivision) (N. or S.) (E. or W.)

or (b) within limits of recorded platted property, town or city:

in Lot _____, Block _____ of _____
(Name of plat or addition)

County of Marion
(If within city or town, give name)

3. Construction Work was begun on June 1946; was completed on July 1946
(Date) (Date)

and the ground water claimed was first used for the purposes set out below on July 1946
(Date)

since which time the water has been used intermittently
(Continuously or intermittently)

from July 1946 to July 1948
(Date) (Date)

4. Quantity of water claimed and used is 24 to 37 gallons per minute; 35 acre feet per year.

5. Purpose or Purposes for which water is used for irrigation of

vegetables
(Domestic, irrigation, municipal, manufacturing, industrial, etc.)

6. Description of Well: Depth 20 feet. Type Flowing well
(Dug or drilled)

diameter 2 inches. Elevation of ground at well site 700 feet, mean sea level.
(As near as known)

Depth to water table 13 feet.

7. Capacity of Well: 400 to 600 g.p.m. with 5 1/2 feet drawdown.

_____ g.p.m. with _____ feet drawdown.

Date of test July 1946

If Flowing Well: Measured discharge _____ g.p.m. on _____
(Date)

Shut-in pressure at ground surface _____ lbs. per sq. in. on _____
(Date)

Water is controlled by _____
(Cap, valve, etc.)

8. Casing: (Give diameter, commercial specifications and depth below ground surface of each casing size.)

4.6 inch diameter *tile casing* from *0* to *2* feet
 8 inch diameter *Steel Casing* from *2* to *30* feet
 inch diameter from to feet
 inch diameter from to feet

Describe and show depth of shoe, plug, adapter, liner or other details: *Foot Valve sets*

twenty three (23) feet below top surface of ground water level from early may till late August about 4 ft below 1 in water level.

9. Perforated Casings or Screens:

3 - 3.6 x 4.8' Concrete tile (6 perforations 1/2" x 10" in follow 6 feet) from to
 24 ft steel casing from to
 drilled 6 ft below casing from to
 Pump lowered 6 ft below surface to *increase yield* from to

10. Log of Well: (Describe each stratum or formation clearly, indicate if water bearing, and give thickness and depth as indicated.)

MATERIAL	Thickness (Feet)	Depth to Bottom (Feet)
<i>Sandy loam</i>	<i>6 ft</i>	<i>6 ft</i>
<i>large boulders 14 ft</i>	<i>14</i>	<i>20 ft</i>
<i>smaller rocks per 20 ft</i>	<i>11</i>	<i>30 ft</i>

If log of well is not available, give name and address of driller. Wymore on Salem

Woodburn Highway

11. Infiltration Trench: Covered or open
Dimensions: Length ft. Minimum depth ft. Maximum depth ft.

Bottom width ft. Discharge g.p.m. Date of test

12. Tunnel: Type of lining

Dimensions:
(Length, course, and cross sectional size)

Position of water bearing stratum with reference to portal of tunnel

Log of tunnel: (Preceding table for log of well may be used, if desired. Give footage from portal and character of materials, as pertinent.)

13. Pumping Equipment: Pump 3 1/4 inch intake 2 1/4 discharge 4000 RPM

(a) Pump 1.0 Horse Electric 3 Phase Capacity 500 g.p.m.
(Make, type and size)

(b) Motor 3 Phase 10 Horse Power
(Type and horsepower)


14. Location of area irrigated or to be irrigated, or place of use if for purposes other than irrigation.

Township North or South	Range E. or W. of Willamette Meridian	Section	Forty-acre Tract	Number Acres To Be Irrigated	Date of Reclamation
9S	2W	24	SW 1/4 NE 1/4	10	1946
"	"	"	SE 1/4 NW 1/4	8	1946
"	"	"	NE 1/4 SE 1/4	2 1/2	1946
				Total 20 1/2 ac	

15. If the ground water supply is supplemental to an existing water supply, identification of any application for a permit, permit, certificate or adjudicated right to appropriate water made or held by the registrant.

Section 24

Township 9S Range 20W W.M.
North

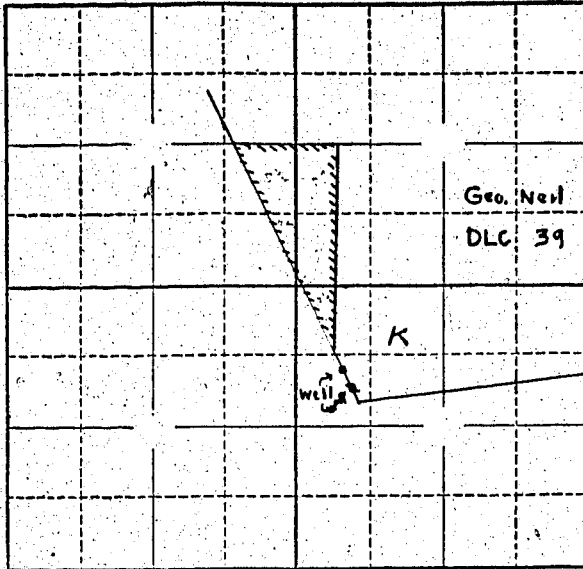

Locate well and acreage of irrigated land on plat.

Scale: 2" = 1 Mile

STATE OF OREGON

County of Marion } ss.

I, William Walter Poole, being first duly sworn, do hereby certify that I have read the foregoing Registration Statement and that all of the items therein contained are true to the best of my knowledge and belief.

William Walter Poole
(Signature of Registrant)

Subscribed and sworn to before me this 12th day of July, 1958

My commission expires MY COMMISSION EXPIRES MAR. 15, 1962 Walt T. Patton
(Notary Public)

(SEAL)

CERTIFICATE OF REGISTRATION

STATE OF OREGON } ss.
County of Marion

This is to certify that the foregoing Registration Statement was received in the office of the State Engineer on the 21st day of July, 1958, at 10⁰⁰ o'clock A M. and has been duly recorded in said office in Book No. 10 of Registration Statements on page GR-2302

Witness my hand this 10th day of March, 1959

1500

Walt T. Patton
(State Engineer)

By _____
(Deputy)

GR - 2302