

Registration Statement

REGISTR

GR-2427

CERTIFICATE NO.

GR-3875

OF CLAIMANT OF RIGHT TO APPROPRIATE GROUND WATER

(Under Chapter 708, Oregon Laws 1955.)

TO THE STATE ENGINEER OF OREGON:

I, George Geiger, George, Geiger of Aloha County of Washington

State of Oregon do hereby make application for a certificate of registration as evidence of a right to appropriate ground water.

1. Source from which water is withdrawn is Pump Well (Flowing well, pump well, infiltration trench, or tunnel)

2. Location is: A Quarter Mile East of A Quarter Mile North from Aloha 3000 S.W. 17th ALSHA (Approximate distance and direction from nearest city or town)

and is more particularly described as follows:

(a) About 490 feet west and 50 feet north from center of Section 7 (Give distance and bearing to corner of section or other legal subdivision)

being within SE 1/4 of NW 1/4 of Sec. 7 Twp. 1 S Rge. 1 W (Smallest legal subdivision) (N. or S.) (E. or W.)

or (b) within limits of recorded platted property, town or city: Johnson Estate Add. of Aloha

in Lot 109115 Block E 1/2 of Lot 115 of Johnson Estate Add (Name of plat or addition)

County of Wash. (If within city or town, give name)

3. Construction Work was begun on July 5, 1949; was completed on July 10, 1949 (Date) (Date)

and the ground water claimed was first used for the purposes set out below on 1949 (Date)

since which time the water has been used continuously from May 1 to October 1 of each year (Continuously or intermittently)

from 1949 to 1958 (Date) (Date)

4. Quantity of water claimed and used is 18 gallons per minute; acre feet per year.

5. Purpose or Purposes for which water is used IRRIGATION OF PASTURE AND GARDEN (Domestic, irrigation, municipal, manufacturing, industrial, etc.)

IRRIGATION OF PASTURE AND GARDEN

6. Description of Well: Depth 115 feet Type drilled (Dug or drilled)

diameter 6 inches Elevation of ground at well site 100 feet, mean sea level. (As near as known)

Depth to water table 75 feet.

7. Capacity of Well: 18 g.p.m. with NONE feet drawdown.

" g.p.m. with feet drawdown.

Date of test July 14, 1949

If Flowing Well: Measured discharge g.p.m. on (Date)

Shut-in pressure at ground surface lbs. per sq. in. on (Date)

Water is controlled by (Cap. valve, etc.)

8. Casing: (Give diameter, commercial specifications and depth below ground surface of each casing size.)

6 inch diameter from 0 to 115 feet
 inch diameter from to feet
 inch diameter from to feet
 inch diameter from to feet

Describe and show depth of shoe, plug, adapter, liner or other details:

9. Perforated Casings or Screens:

(Number per foot and size of perforations, or describe screen) from to
 from to
 from to
 from to

10. Log of Well: (Describe each stratum or formation clearly, indicate if water bearing, and give thickness and depth as indicated.)

MATERIAL	Thickness (Feet)	Depth to Bottom (Feet)
TOP SOIL	1 FT	114
HARD CLAY	20	94
Blue clay	86	8
SANDSTONE	9	WATER

If log of well is not available, give name and address of driller.

11. Infiltration Trench: Covered or open

Dimensions: Length ft. Minimum depth ft. Maximum depth ft.

Bottom width ft. Discharge g.p.m. Date of test

12. Tunnel: Type of lining

Dimensions:
(Length, course, and cross sectional size)

Position of water bearing stratum with reference to portal of tunnel

Log of tunnel: (Preceding table for log of well may be used, if desired. Give footage from portal and character of materials, as pertinent.)

13. Pumping Equipment:

(a) Pump JOHNSON JET Capacity 18 g.p.m.
(Make, type and size)


(b) Motor SINGLE PHASE 1 horsepower
(Type and horsepower)

14. Location of area irrigated or to be irrigated, or place of use if for purposes other than irrigation.

Township North or South	Range E. or W. of Willamette Meridian	Section	Forty-acre Tract	Number Acres To Be Irrigated	Date of Reclamation
T1S	R1W	5	NE 1/4 of SW 1/4	1 1/2 ACRES	1949
"	(16) E	115	SE 1/4 of NW 1/4	1 ACRE	"
				2.5 Ac	

15. If the ground water supply is supplemental to an existing water supply, identification of any application for a permit, permit, certificate or adjudicated right to appropriate water made or held by the registrant.

Township 15 Range 1W W.M.
North

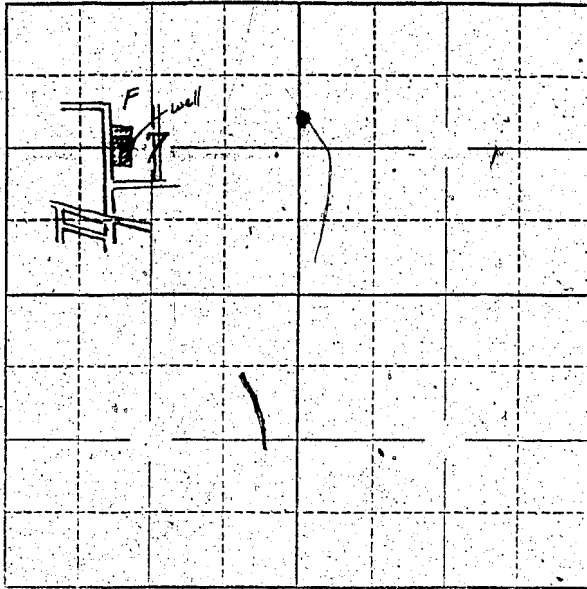

Locate well and acreage of irrigated land on plat.

Scale: 2" = 1 Mile

STATE OF OREGON

County of Washington } ss.

I, George E. Geiger, being first duly sworn, do hereby certify that I have read the foregoing Registration Statement and that all of the items therein contained are true to the best of my knowledge and belief.

George E. Geiger
(Signature of Registrant)

Subscribed and sworn to before me this 11th day of July, 19 58

My commission expires 2-8-62

Edward Adams
(Notary Public)

(SEAL)

CERTIFICATE OF REGISTRATION

STATE OF OREGON } ss.

County of Marion

This is to certify that the foregoing Registration Statement was received in the office of the State Engineer on the 14th day of July, 19 58, at 8:00 o'clock A. M. and has been duly recorded in said office in Book No. 16 of Registration Statements, on page 3875

~~**Construction shall be completed by 19 and the water completely applied to beneficial use by 19**~~

Witness my hand this 28th day of December, 19 59

Alvin A. Estender
(State Engineer)

By _____
(Deputy)

GR-3875