

Registration No. GR. - 2429

Certificate No. GR. - 2304

Registration Statement

OF CLAIMANT OF RIGHT TO APPROPRIATE GROUND WATER

TO THE STATE ENGINEER OF OREGON:

I, Fred S. McCall
of Route 2, Box 75 County of Marion
(Mailing address)
State of Oregon do hereby make application for a certificate of registration as evidence of a right to appropriate ground water.

1. Source from which water is withdrawn is Pump well
(Flowing well, pump well, infiltration trench, or tunnel)
2. Location is: 6 1/2 miles Northwest Salem
(Approximate distance and direction from nearest city or town)

and is more particularly described as follows:

(a) 1688 ft N. and 870 ft E from the 1/4 corner of South Boundary of Sec 28.
(Give distance and bearing to corner of section or other legal subdivision)
being within N.W. 1/4 of SE 4 of Sec. 28, Twp. 6 S, Rge. 3 W.
(Smallest legal subdivision) (N. or S.) (E. or W.)

or (b) within limits of recorded platted property, town or city: _____

in Lot _____, Block _____ of _____
(Name of plat or addition)
County of _____
(If within city or town, give name)

3. Construction Work was begun on May - 1949; was completed on May - 1949
(Date) (Date)
and the ground water claimed was first used for the purposes set out below on June - 1949
(Date)
since which time the water has been used Intermittently - Irrigation farm crops.
(Continuously or intermittently)
from June to Sept.
(Date) (Date)

4. Quantity of water claimed and used is 420 gallons per minute; _____ acre feet per year.

5. Purpose or Purposes for which water is used Irrigation
(Domestic, irrigation, municipal, manufacturing, industrial, etc.)

6. Description of Well: Depth 22 feet. Type Drilled
(Dug or drilled)
diameter 10 inches. Elevation of ground at well site River Bottom feet, mean sea level.
(As near as known)
Depth to water table 1 feet.

7. Capacity of Well: 420 g.p.m. with 1 ft. feet drawdown.
_____ g.p.m. with _____ feet drawdown.

Date of test _____

If Flowing Well: Measured discharge _____ g.p.m. on _____
(Date)

Shut-in pressure at ground surface _____ lbs. per sq. in. on _____
(Date)

Water is controlled by _____
(Cap, valve, etc.)

8. Casing: (Give diameter, commercial specifications and depth below ground surface of each casing size.)

10 inch diameter from 1 to 23 feet
 inch diameter from to feet
 inch diameter from to feet
 inch diameter from to feet

Describe and show depth of shoe, plug, adapter, liner or other details:

9. Perforated Casings or Screens:

120 perforations from 3ft to 20ft.
(Number per foot and size of perforations, or describe screen)
 from to
 from to
 from to

10. Log of Well: (Describe each stratum or formation clearly, indicate if water bearing, and give thickness and depth as indicated.)

MATERIAL	Thickness (Feet)	Depth to Bottom (Feet)
Topsoil	1ft	1ft
Sandy Clay	2ft	3ft
Water Gravel	3ft	23ft

If log of well is not available, give name and address of driller.....

11. Infiltration Trench: Covered or open

Dimensions: Length ft. Minimum depth ft. Maximum depth ft.

Bottom width ft. Discharge g.p.m. Date of test

12. Tunnel: Type of lining

Dimensions:
(Length, course, and cross sectional size)

Position of water bearing stratum with reference to portal of tunnel

Log of tunnel: (Preceding table for log of well may be used, if desired. Give footage from portal and character of materials, as pertinent.)

13. Pumping Equipment:

(a) Pump Pacific - cont. 4" x 3" Capacity 420 g.p.m.
(Make, type and size)


(b) Motor Electric - 15 H.P.
(Type and horsepower)

14. Location of area irrigated or to be irrigated, or place of use if for purposes other than irrigation.

Township North or South	Range E. or W. of Willamette Meridian	Section	Forty-acre Tract	Number Acres To Be Irrigated	Date of Reclamation
6S	3W	28	SW. 1/4 of NE 1/4	13 ⁶⁴ / ₁₀₀	June-1949
6S	3W	28	SE. 1/4 of NE 1/4	7 ⁸⁹ / ₁₀₀	" "
6S	3W	28	N.W. 1/4 of SE 1/4	35 ²⁷ / ₁₀₀	" "
6S	3W	28	N.E. 1/4 of SE 1/4	7 ⁶⁴ / ₁₀₀	" "
6S	3W	28	SW. 1/4 of SE 1/4	13 ²² / ₁₀₀	" "
6S	3W	28	SE. 1/4 of SE 1/4	4 ⁷⁵ / ₁₀₀	" "
			Total	77.36	

15. If the ground water supply is supplemental to an existing water supply, identification of any application for a permit, permit, certificate or adjudicated right to appropriate water made or held by the registrant.

Township 65 Range 3W W.M.
North

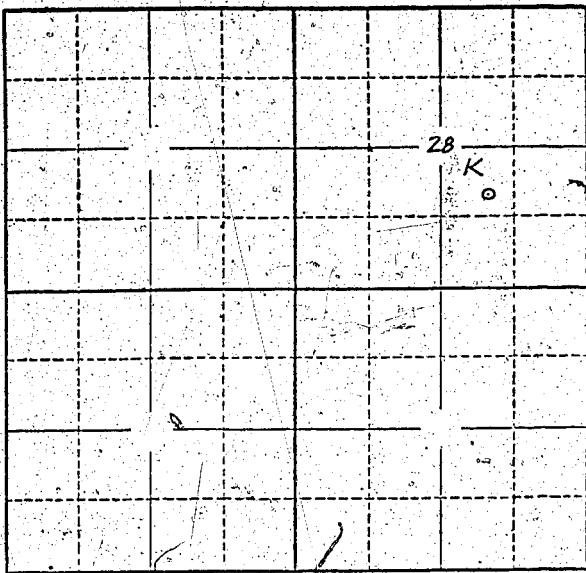

Locate well and acreage of irrigated land on plat.
Scale: 2" = 1 Mile

STATE OF OREGON

County of Marion } ss.

I, Fred S. McCall, being first duly sworn, do hereby certify that I have read the foregoing Registration Statement and that all of the items therein contained are true to the best of my knowledge and belief.

Fred S. McCall
(Signature of Registrant)

Subscribed and sworn to before me this 22nd day of July, 1958.

My commission expires Sept. 8, 1960 Chas. E. [Signature]
(Notary Public)

(SEAL)

CERTIFICATE OF REGISTRATION

STATE OF OREGON } ss.
County of Marion

This is to certify that the foregoing Registration Statement was received in the office of the State Engineer on the 22 day of July, 1958, at 9:30 o'clock A-M. and has been duly recorded in said office in Book No. 10 of Registration Statements on page GR-2304

Witness my hand this 10th day of March, 1959.

\$ 22.20

[Signature]
(State Engineer)

By _____
(Deputy)

GR - 2304