

Well No I  
1905

Registration No. GR - 2434  
Certificate No. GR - 2309

# Registration Statement

## OF CLAIMANT OF RIGHT TO APPROPRIATE GROUND WATER

TO THE STATE ENGINEER OF OREGON;

I, Mildred Hill DBA Weirline Hop Ranch  
of At 1 Box 46 Independence County of Polk  
State of Oregon, do hereby make application for a certificate of registration as evidence  
of a right to appropriate ground water.

- 1. Source from which water is withdrawn is Pump well #1  
(Flowing well, pump, well, infiltration trench, or tunnel)
- 2. Location is: 6 miles SE of Independence  
(Approximate distance and direction from nearest city or town)

and is more particularly described as follows:

(a) 1450' S. 600' E. of NW corner Section 7  
(Give distance and bearing to corner of section or other legal subdivision)  
being within SW 1/4 of NW 1/4 of Sec. 7, Twp. 9 S, Rge. 4 E  
(Smallest legal subdivision) (N. or S.) (E. or W.)

or (b) within limits of recorded platted property, town or city:  
in Lot \_\_\_\_\_, Block \_\_\_\_\_ of \_\_\_\_\_  
(Name of plat or addition)

County of Polk  
(If within city or town, give name)

3. Construction Work was begun on 1949; was completed on 1949  
(Date) (Date)

and the ground water claimed was first used for the purposes set out below on 1949  
(Date)

since which time the water has been used \_\_\_\_\_  
(Continuously or Intermittently)  
from May 20 to Sept 15 each year  
(Date) (Date)

4. Quantity of water claimed and used is 800 gallons per minute; 13.5 acre  
feet per year.

5. Purpose or Purposes for which water is used \_\_\_\_\_

6. Description of Well: Depth 3.6 feet. Type Drilled  
(Domestic, irrigation, municipal, manufacturing, industrial, etc.) (Dug or drilled)

diameter 10 inches. Elevation of ground at well site unknown feet, mean sea level.  
(As near as known)

Depth to water table 16 feet.

7. Capacity of Well: 800 g.p.m. with 2 feet drawdown.  
\_\_\_\_\_ g.p.m. with \_\_\_\_\_ feet drawdown.

Date of test \_\_\_\_\_

If Flowing Well: Measured discharge \_\_\_\_\_ g.p.m. on \_\_\_\_\_  
(Date)


Shut-in pressure at ground surface \_\_\_\_\_ lbs. per sq. in. on \_\_\_\_\_  
(Date)

Water is controlled by \_\_\_\_\_  
(Cap. valve, etc.)





Township 9S Range 4W W.M.  
North

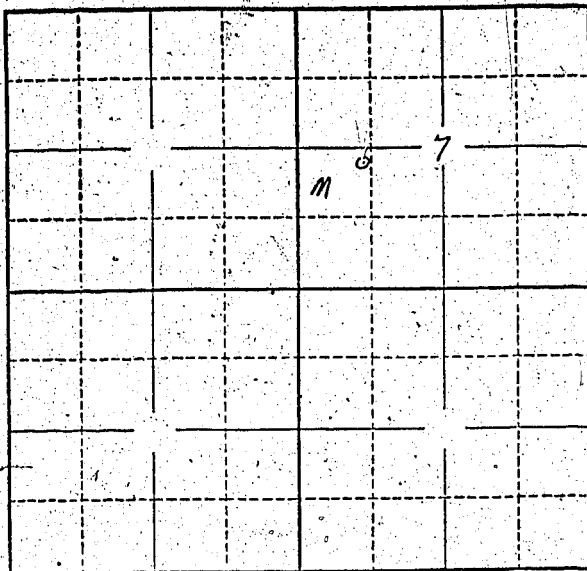

Locate well and acreage of irrigated land on plat.  
Scale: 2" = 1 Mile

STATE OF OREGON

County of Marion } ss.

I, Mildred Hill, being first duly sworn, do hereby certify that I have read the foregoing Registration Statement and that all of the items therein contained are true to the best of my knowledge and belief.

Mildred Hill

(Signature of Registrant)

Subscribed and sworn to before me this 22<sup>nd</sup> day of July, 1958.

My commission expires Sept 8, 1960

Charles [Signature]

(Notary Public)

(SEAL)

### CERTIFICATE OF REGISTRATION

STATE OF OREGON

County of Marion } ss.

This is to certify that the foregoing Registration Statement was received in the office of the State Engineer on the 22nd day of July, 1958, at 10:45 o'clock A. M. and has been duly recorded in said office in Book No. 10 of Registration Statements on page GR-2300

Witness my hand this 10<sup>th</sup> day of March, 1959

Laura A. Stanley

(State Engineer)

By \_\_\_\_\_ (Deputy)

GR - 2300

#19.05