

Well No. 2  
22.85

Registration No. GR-2435  
Certificate No. GR-2310

# Registration Statement

## OF CLAIMANT OF RIGHT TO APPROPRIATE GROUND WATER

TO THE STATE ENGINEER OF OREGON:

I, Melred Hill 10 B9 Warline Hop Ranch  
of Rt 1 Box 46 Independence Ore County of Polk  
(Mailing address)

State of Oregon, do hereby make application for a certificate of registration as evidence of a right to appropriate ground water.

1. Source from which water is withdrawn is Pump well # 2  
(Flowing well, pump well, infiltration trench, or tunnel)
2. Location is: 6 miles S E of Independence  
(Approximate distance and direction from nearest city or town)

and is more particularly described as follows:

(a) 1000".5 700" W A NE Corner Section 12  
(Give distance and bearing to corner of section or other legal subdivision)  
being within NE 1/4 & NE 1/4 of Sec. 12 Twp. 9.5 Rge. 4  
(Smallest legal subdivision) (N. of S.) (E. or W.)

or (b) within limits of recorded platted property, town or city:  
in Lot \_\_\_\_\_ Block \_\_\_\_\_ of \_\_\_\_\_  
(Name of plat or addition)

County of Polk  
(If within city or town, give name)

3. Construction Work was begun on 1949; was completed on 1949  
(Date) (Date)  
and the ground water claimed was first used for the purposes set out below on 1949  
(Date)

since which time the water has been used Continuously  
(Continuously or Intermittently)  
from Sept 15 each year  
(Date) (Date)

4. Quantity of water claimed and used is 800 gallons per minute; 206 acre feet per year.

5. Purpose or Purposes for which water is used Irrigation  
(Domestic, irrigation, municipal, manufacturing, industrial, etc.)

6. Description of Well: Depth 35 feet. Type Drilled  
(Dug or drilled)  
diameter 10 inches. Elevation of ground at well site 235 feet, mean sea level.  
(As near as known)  
Depth to water table 16 feet.

7. Capacity of Well: 800 g.p.m. with 2 feet drawdown.  
\_\_\_\_\_ g.p.m. with \_\_\_\_\_ feet drawdown.

Date of test May 31

If Flowing Well: Measured discharge \_\_\_\_\_ g.p.m. on \_\_\_\_\_  
(Date)


Shut-in pressure at ground surface \_\_\_\_\_ lbs. per sq. in. on \_\_\_\_\_  
(Date)

Water is controlled by \_\_\_\_\_  
(Cap, valve, etc.)





Township 9S Range 4W W.M.  
North

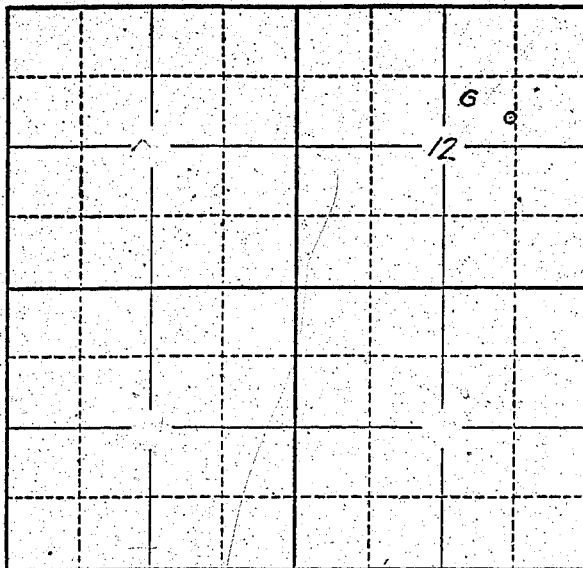

Locate well and acreage of irrigated land on plat.  
Scale: 2" = 1 Mile

STATE OF OREGON

County of Marion } ss.

I, Mildred Hill, being first duly sworn, do hereby certify that I have read the foregoing Registration Statement and that all of the items therein contained are true to the best of my knowledge and belief.

Mildred Hill  
(Signature of Registrant)

Subscribed and sworn to before me this 22<sup>nd</sup> day of July, 1958.

My commission expires Sept. 8, 1960

Chas. T. Walker  
(Notary Public)

(SEAL)

### CERTIFICATE OF REGISTRATION

STATE OF OREGON

County of Marion } ss.

This is to certify that the foregoing Registration Statement was received in the office of the State Engineer on the 22<sup>nd</sup> day of July, 1958, at 10<sup>45</sup> o'clock A.M. and has been duly recorded in said office in Book No. 10 of Registration Statements on page GR-2310

Witness my hand this 10<sup>th</sup> day of March, 1959.

Edward H. Stanley  
(State Engineer)

By \_\_\_\_\_ (Deputy)

GR - 2310