

# Registration Statement

## OF CLAIMANT OF RIGHT TO APPROPRIATE GROUND WATER

### TO THE STATE ENGINEER OF OREGON:

I, Ralph Lester Beach and Edith G. Beach  
of Route 1, Box 217-D, Aumsville County of Marion  
(Mailing address)

State of Oregon, do hereby make application for a certificate of registration as evidence of a right to appropriate ground water.

1. Source from which water is withdrawn is Flowing Well  
(Flowing well, pump well, infiltration trench, or tunnel)

2. Location is: 1 mile South and 1 mile West of Aumsville;  
(Approximate distance and direction from nearest city or town)

and is more particularly described as follows:

(a) 280 feet N and 235 Feet West from the S.E. Corner of the NE/4 of SW/4  
(Give distance and bearing to corner of section or other legal subdivision)

being within the NE/4 of the SW/4 of Sec. 35, Twp. 8 S, Rge. 2 N W M  
(Smallest legal subdivision) (N. or S.) (E. or W.)

or (b) within limits of recorded platted property, town or city:

in Lot \_\_\_\_\_, Block \_\_\_\_\_ of \_\_\_\_\_  
(Name of plat or addition)

County of \_\_\_\_\_  
(If within city or town, give name)

3. Construction Work was begun on Spring 1947; was completed on Spring 1947  
(Date) (Date)

and the ground water claimed was first used for the purposes set out below on Spring 1947,  
(Date)

since which time the water has been used Continuously  
(Continuously or intermittently)

from Spring 1947 to Date  
(Date) (Date)

4. Quantity of water claimed and used is 375 gallons per minute; 116 acre feet per year.

5. Purpose or Purposes for which water is used irrigation

(Domestic, irrigation, municipal, manufacturing, industrial, etc.)

6. Description of Well: Depth \_\_\_\_\_ feet. Type \_\_\_\_\_  
(Dug or drilled)

diameter \_\_\_\_\_ inches. Elevation of ground at well site \_\_\_\_\_ feet, mean sea level.  
(As near as known)

Depth to water table \_\_\_\_\_ feet.

7. Capacity of Well: \_\_\_\_\_ g.p.m. with \_\_\_\_\_ feet drawdown.

\_\_\_\_\_ g.p.m. with \_\_\_\_\_ feet drawdown.

Date of test \_\_\_\_\_

If Flowing Well: Measured discharge \_\_\_\_\_ g.p.m. on \_\_\_\_\_  
(Date)

Shut-in pressure at ground surface \_\_\_\_\_ lbs. per sq. in. on \_\_\_\_\_  
(Date)

Water is controlled by Not controlled  
(Cap, valve, etc.)

8. Casing: (Give diameter, commercial specifications and depth below ground surface of each casing size.)

..... inch diameter ..... from ..... to ..... feet  
 ..... inch diameter ..... from ..... to ..... feet  
 ..... inch diameter ..... from ..... to ..... feet  
 ..... inch diameter ..... from ..... to ..... feet

Describe and show depth of shoe, plug, adapter, liner or other details: .....

.....  
 .....

9. Perforated Casings or Screens:

..... from ..... to .....  
(Number per foot and size of perforations, or describe screen)  
 ..... from ..... to .....  
 ..... from ..... to .....  
 ..... from ..... to .....

10. Log of Well: (Describe each stratum or formation clearly, indicate if water bearing, and give thickness and depth as indicated.)

MATERIAL	Thickness (Feet)	Depth to Bottom (Feet)

If log of well is not available, give name and address of driller. .... None .....

11. Infiltration Trench: Covered or open ..... Open .....

Dimensions: Length ..... 65 ..... ft. Minimum depth ..... 11 ..... ft. Maximum depth ..... 11 ..... ft.

Bottom width ..... 20 ..... ft. Discharge ..... 375 ..... g.p.m. Date of test .....

12. Tunnel: Type of lining .....

Dimensions: .....  
(Length, course, and cross-sectional size)

Position of water bearing stratum with reference to portal of tunnel .....

Log of tunnel: (Preceding table for log of well may be used, if desired. Give footage from portal and character of materials, as pertinent.)

13. Pumping Equipment:

(a) Pump Pacific 3 1/2 intake 2 1/2 discharge ..... Capacity ..... 375 ..... g.p.m.  
(Make, type and size)


(b) Motor 7 1/2 horse power single phase general electric .....  
(Type and horsepower)

14. Location of area irrigated or to be irrigated, or place of use if for purposes other than irrigation.

Township XXXXXX South	Range XXXXX W. of Willamette Meridian	Section	Forty-acre Tract	Number Acres To Be Irrigated	Date of Reclamation
T 8 S	2 W	35	NE/4 of SW/4	30 A	1947

15. If the ground water supply is supplemental to an existing water supply, identification of any application for a permit, permit, certificate or adjudicated right to appropriate water made or held by the registrant.  
None

Township S 26 Range W 26 W.M.

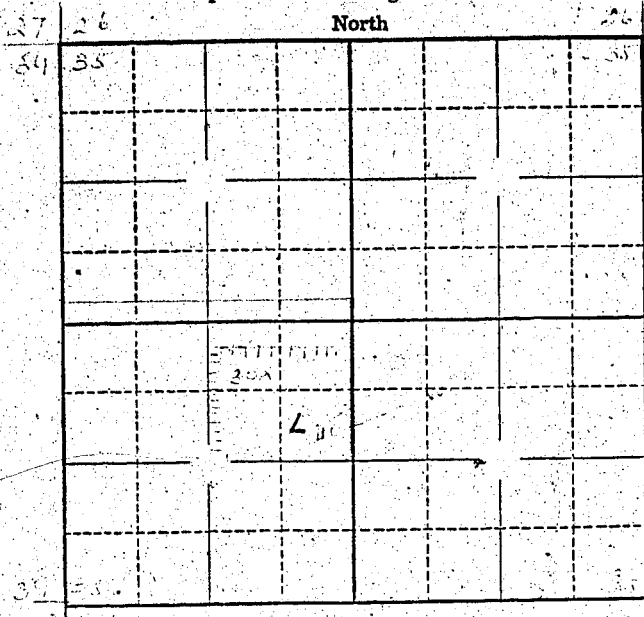

Locate well and acreage of irrigated land on plat.  
Scale: 2" = 1 Mile

STATE OF OREGON

County of Marion

} ss.

I, Ralph L. Beach, being first duly sworn, do hereby certify that I have read the foregoing Registration Statement and that all of the items therein contained are true to the best of my knowledge and belief.

(Signature of Registrant)

Subscribed and sworn to before me this        day of July, 1958

My commission expires 9-9-59

Charles W. Creighton, Jr.

(SEAL)

**CERTIFICATE OF REGISTRATION**

STATE OF OREGON

County of Marion

} ss.

This is to certify that the foregoing Registration Statement was received in the office of the State Engineer on the 22 day of July, 1958, at 8:00 o'clock A. M. and has been duly recorded in said office in Book No. 10 of Registration Statements on page GR-231!

Witness my hand this 10<sup>th</sup> day of March, 1959

Lewis J. Stanley  
(State Engineer)

By         
(Deputy)

\$1500

GR-231!