

Registration Statement

OF CLAIMANT OF RIGHT TO APPROPRIATE GROUND WATER

TO THE STATE ENGINEER OF OREGON:

I, George F. Horning

of Route 3, Box 588, Corvallis County of Benton
(Mailing address)

State of Oregon do hereby make application for a certificate of registration as evidence of a right to appropriate ground water.

1. Source from which water is withdrawn is pump well
(Flowing well, pump well, infiltration trench, or tunnel)

2. Location is: 12 miles south of Corvallis
(Approximate distance and direction from nearest city or town)

and is more particularly described as follows:

(a) 165' W hence 1117' S 41° 51' E from the center of
(Give distance and bearing to corner of section or other legal subdivision)

being within NW 1/4 of SE 1/4 of Sec. 36, Twp. 13 S, Rge. 5 W
(Smallest legal subdivision) (N. or S.) (E. or W.)

or (b) within limits of recorded platted property, town or city:

in Lot _____ Block _____ of _____
(Name of plat or addition)

County of _____
(If within city or town, give name)

3. Construction Work was begun on 1948; was completed on 1948
(Date) (Date)

and the ground water claimed was first used for the purposes set out below on 1948
(Date)

since which time the water has been used continuously
(Continuously or Intermittently)

from 1948 to 1957
(Date) (Date)

4. Quantity of water claimed and used is 300 gallons per minute; 127 acre feet per year.

5. Purpose or Purposes for which water is used irrigation

(Domestic, irrigation, municipal, manufacturing, industrial, etc.)

6. Description of Well: Depth 25 feet. Type consists of 2 driven casings located 6" apart
(Dug or drilled)

diameter 3 & 4 inches. Elevation of ground at well site 225 feet, mean sea level.
(As near as known)

Depth to water table 12 feet.

7. Capacity of Well: 500 g.p.m. with pump draws directly from casing.
~~_____ g.p.m. with _____ feet drawdown.~~


Date of test 1948

If Flowing Well: Measured discharge _____ g.p.m. on _____
(Date)

Shut-in pressure at ground surface _____ lbs. per sq. in. on _____
(Date)

Water is controlled by _____
(Cap. valve, etc.)

Township 13 S Range 5 W, W.M.
North

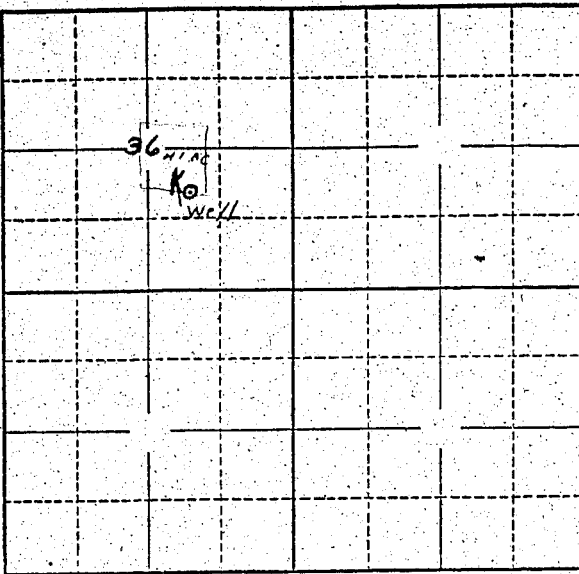

Locate well and acreage of irrigated land on plat.
Scale: 2" = 1 Mile

STATE OF OREGON

County of BENTON ss.

I, GEORGE F. MORNING, being first duly sworn, do hereby certify that I have read the foregoing Registration Statement and that all of the items therein contained are true to the best of my knowledge and belief.

George F. Morning
(Signature of Registrant)

Subscribed and sworn to before me this 13th day of JUNE, 1958

My commission expires JULY 25, 1958
(Notary Public)

(SEAL)

CERTIFICATE OF REGISTRATION

STATE OF OREGON }
County of Marion } ss.

This is to certify that the foregoing Registration Statement was received in the office of the State Engineer on the 22nd day of July, 1958, at 6:00 o'clock A.M. and has been duly recorded in said office in Book No. 10 of Registration Statements on page GR 2313

Witness my hand this 10th day of March, 1959

Lawrence A. Stanley
(State Engineer)

By _____ (Deputy)

#18-15

GR - 2313