

Registration Statement

OF CLAIMANT OF RIGHT TO APPROPRIATE GROUND WATER

TO THE STATE ENGINEER OF OREGON:

I, George F. Horning

of Route 3, Box 588, Corvallis County of Benton

State of Oregon, do hereby make application for a certificate of registration as evidence of a right to appropriate ground water.

1. Source from which water is withdrawn is pump well
(Flowing well, pump well, infiltration, trench, or tunnel)
2. Location is: 12 miles South of Corvallis
(Approximate distance and direction from nearest city or town)

and is more particularly described as follows:

(a) 165' W hence S 72° 45' E, 2071' from the center of
(Give distance and bearing to corner of section or other legal subdivision)

being within NE 1/4 of SE 1/4 of Sec. 36, Twp. 13 S, Rge. 5 W
(Smallest legal subdivision) (N. or S.) (E. or W.)

or (b) within limits of recorded platted property, town or city:

in Lot _____, Block _____ of _____
(Name of plat or addition)

County of _____
(If within city or town, give name)

3. Construction Work was begun on 1948; was completed on 1948
(Date) (Date)

and the ground water claimed was first used for the purposes set out below on 1948
(Date)

since which time the water has been used continuously
(Continuously or intermittently)

from 1948 to 1957
(Date) (Date)

4. Quantity of water claimed and used is 800 while operating 100 acre feet per year.
gallons per minute;

5. Purpose or Purposes for which water is used irrigation

(Domestic, irrigation, municipal, manufacturing, industrial, etc.)

6. Description of Well: Depth 25 feet. Type driven
(Dug or drilled)

diameter 5 inches. Elevation of ground at well site 225 feet, mean sea level.
(As near as known)

Depth to water table 12 feet.

7. Capacity of Well: 800 g.p.m. with pump draws directly from casing.
~~FEET DRAWDOWN~~
_____ g.p.m. with _____ feet drawdown.

Date of test 1948

If Flowing Well: Measured discharge _____ g.p.m. on _____
(Date)

Shut-in pressure at ground surface _____ lbs. per sq. in. on _____
(Date)

Water is controlled by _____
(Cap. valve, etc.)

8. Casing: (Give diameter, commercial specifications and depth below ground surface of each casing size.)

5 inch diameter steel from surface to 20 feet
inch diameter from to feet
inch diameter from to feet
inch diameter from to feet

Describe and show depth of shoe, plug, adapter, liner or other details:

9. Perforated Casings or Screens:

slotted from 20' to 25'
(Number per foot and size of perforations, or describe screen)
from to
from to
from to

10. Log of Well: (Describe each stratum or formation clearly, indicate if water bearing, and give thickness and depth as indicated.)

| MATERIAL | Thickness (Feet) | Depth to Bottom (Feet) |
|----------|------------------|------------------------|
| unknown | | |
| | | |
| | | |
If log of well is not available, give name and address of driller.

11. Infiltration Trench: Covered or open

Dimensions: Length ft. Minimum depth ft. Maximum depth ft.
 Bottom width ft. Discharge g.p.m. Date of test

12. Tunnel: Type of lining

Dimensions:
(Length, course, and cross sectional size)

Position of water bearing stratum with reference to portal of tunnel

Log of tunnel: (Preceding table for log of well may be used, if desired. Give footage from portal and character of materials, as pertinent.)

13. Pumping Equipment:


(a) Pump 5 x 4" centrifugal Capacity 800 g.p.m.
(Make, type and size)
 (b) Motor Case stationary gas unit 40 hp
(Type and horsepower)

14. Location of area irrigated or to be irrigated, or place of use if for purposes other than irrigation.

| Township North or South | Range E. or W. of Willamette Meridian | Section | Forty-acre Tract | Number Acres To Be Irrigated | Date of Reclamation |
|-------------------------|---------------------------------------|---------|-----------------------------------|------------------------------|---------------------|
| 13 S | 5 W | 36 | SE $\frac{1}{4}$ NE $\frac{1}{4}$ | 20.0 | 1948 |
| 13 S | 5 W | 36 | NE $\frac{1}{4}$ SE $\frac{1}{4}$ | 17.5 | 1948 |
| 13 S | 5 W | 36 | SW $\frac{1}{4}$ NE $\frac{1}{4}$ | 1.5 | 1948 |
| 13 S | 5 W | 36 | NW $\frac{1}{4}$ SE $\frac{1}{4}$ | 1.0 | 1948 |
| | | | | Total | 40.0 |
| | | | | | |
| | | | | | |
15. If the ground water supply is supplemental to an existing water supply, identification of any application for a permit, permit, certificate or adjudicated right to appropriate water made or held by the registrant.

Township 13 S Range 5 W, W.M.
North

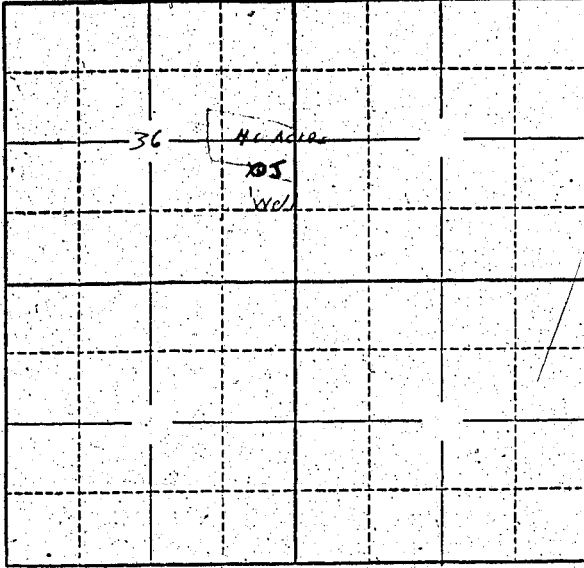

Locate well and acreage of irrigated land on plat.
Scale: 2" = 1 Mile

STATE OF OREGON

County of BENSON } ss.

I, GEORGE F. HORNING being first duly sworn, do hereby certify that I have read the foregoing Registration Statement and that all of the items therein contained are true to the best of my knowledge and belief.

George F. Horning
(Signature of Registrant)

Subscribed and sworn to before me this 13th day of JUNE, 1923

My commission expires JULY 25, 1922

(Notary Public)

(SEAL)

CERTIFICATE OF REGISTRATION

STATE OF OREGON

County of Marion } ss.



Laura A. Stanley
(State Engineer)

By _____
(Deputy)

#1650