

Registration Statement

OF CLAIMANT OF RIGHT TO APPROPRIATE GROUND WATER

TO THE STATE ENGINEER OF OREGON:

I, Ted R DeWitte
 of 1804 SE Powell Blvd Portland 36, Ore County of Multnomah
(Mailing address)
 State of Ore, do hereby make application for a certificate of registration as evidence
 of a right to appropriate ground water.

1. Source from which water is withdrawn is Pump well
(Flowing well, pump well, infiltration trench, or tunnel)
 2. Location is: 2 1/2 mi. West of Greban on Powell Blvd.
(Approximate distance and direction from nearest city or town)

and is more particularly described as follows:

(a) Distance to well 270' Bearing N 89° 43' 30" W from Corner Pt.
(Give distance and bearing to corner of section or other legal subdivision)
 being within SE 1/4 of the SE 1/4 of Sec. 7, Twp. 15, Rge. 53 E
(Smallest legal subdivision) (N. or S.) (E. or W.)

or (b) within limits of recorded platted property, town or city:
 in Lot _____, Block _____ of _____
(If within city or town, give name) County of Multnomah
(Name of plat or addition)

3. Construction Work was begun on 6/5/54; was completed on 6/15/54
(Date) (Date)
 and the ground water claimed was first used for the purposes set out below on 8/15/54
(Date)

since which time the water has been used Continuously or Intermittently
(Continuously or Intermittently)
 from 8/15/54 to 7/15/58
(Date) (Date)

4. Quantity of water claimed and used is 80 gallons per minute; 55 acre
 feet per year.

5. Purpose or Purposes for which water is used Irrigation

(Domestic, irrigation, municipal, manufacturing, industrial, etc.)

6. Description of Well: Depth 60 feet. Type Drilled
(Dig or drilled)
 diameter 8 inches. Elevation of ground at well site 250 feet, mean sea level.
(As near as known)
 Depth to water table 30 feet.

7. Capacity of Well: 90 g.p.m. with 20 feet drawdown.
 _____ g.p.m. with _____ feet drawdown.

Date of test 8/10/54

If Flowing Well: Measured discharge _____ g.p.m. on _____
(Date)

Shut-in pressure at ground surface _____ lbs. per sq. in. on _____
(Date)

Water is controlled by _____
(Cap. valve, etc.)

8. **Casing:** (Give diameter, commercial specifications and depth below ground surface of each casing)

8" inch diameter from 0 to 60' feet

Shoe at 60'


Torch Cut

(Number per foot and size of perforations, or describe screen)

10. **Log of Well:** (Describe each stratum or formation clearly, indicate if water bearing, and give thick-

Gravel & Clay
Sand & Gravel

Township 15 Range 3 E, W.M.
North

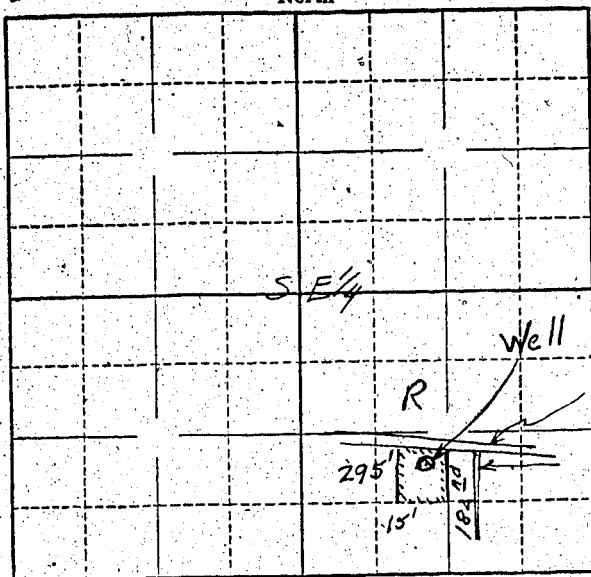

Locate well and acreage of irrigated land on plat.

Scale: $\frac{1}{8}$ - 1 Mile
8"

STATE OF OREGON

County of Multnomah } ss.

I, J. L. DeWitte, being first duly sworn, do hereby certify that I have read the foregoing Registration Statement and that all of the items therein contained are true to the best of my knowledge and belief.

J. L. DeWitte
(Signature of Registrant)

Subscribed and sworn to before me this 31st day of July, 1958

My commission expires 10-10-59

Madison S. L.
(Notary Public)

(SEAL)

CERTIFICATE OF REGISTRATION

STATE OF OREGON

County of Marion } ss.

This is to certify that the foregoing Registration Statement was received in the office of the State Engineer on the 22 day of July, 1958, at 5:00 o'clock A.M. and has been duly recorded in said office in Book No. 10 of Registration Statements on page GR-2315

Witness my hand this 10th day of March, 1959

Lewis A. Bittles
(State Engineer)

By

(Deputy)

GR - 2315