

Registration Statement

OF CLAIMANT OF RIGHT TO APPROPRIATE GROUND WATER



TO THE STATE ENGINEER OF OREGON:

I, THE CALIFORNIA OREGON POWER COMPANY

of 216 W. Main St., Medford, County of Jackson
(Mailing address)

State of Oregon, do hereby make application for a certificate of registration as evidence of a right to appropriate ground water.

1. Source from which water is withdrawn is pump well
(Flowing well, pump well, infiltration trench, or tunnel)

2. Location is: Medford, Oregon
(Approximate distance and direction from nearest city or town)

and is more particularly described as follows: Starting at NE Corner D.L.C. #42; thence West, 1786 ft. to NE Corner of Substation Property; thence on bearing S 53° W, 305 ft. to well site.

(a) 1560 ft. East + 800 ft. North
SW Corner Section 19
SE 1/4 of SW 1/4
(Give distance and bearing to corner of section or other legal subdivision)

being within Donation Land Claim #42 of Sec. 19, Twp. 37 S, Rge. 1 W., W.M.
(Smallest legal subdivision) (N. or S.) (E. or W.)

or (b) within limits of recorded platted property, town or city:

in Lot 7, Block _____ of _____
(Name of plat or addition)

Medford County of Jackson
(If within city or town, give name)

3. Construction Work was begun on 1929; was completed on 1930
(Date) (Date)

and the ground water claimed was first used for the purposes set out below on 1930
(Date)

since which time the water has been used continuously
(Continuously or intermittently)

from 1930 to present date
(Date) (Date)

4. Quantity of water claimed and used is 40 gallons per minute; 12 acre feet per year.

5. Purpose or Purposes for which water is used irrigation at substation

(Domestic, irrigation, municipal, manufacturing, industrial, etc.)

6. Description of Well: Depth 14 feet. Type dug
(Dug or drilled)

1 1/2' x 4' bottom
diameter 3 1/2' x 6' top pinches. Elevation of ground at well site 1340.55 feet, mean sea level.
(As near as known)

Depth to water table 4.8 feet.

7. Capacity of Well: 40 g.p.m. with 7 feet drawdown.

_____ g.p.m. with _____ feet drawdown.

Date of test 1930

If Flowing Well: Measured discharge Does not apply g.p.m. on _____
(Date)

Shut-in pressure at ground surface _____ lbs. per sq. in. on _____
(Date)

Water is controlled by _____
(Cap, valve, etc.)

8. Casing: (Give diameter, commercial specifications and depth below ground surface of each casing size.)

3 1/2 x 6 ft. inch diameter	poured concrete lining - 4 inches	from	0	to	5	feet
2 1/2 x 5 ft. inch diameter	" " " " "	from	5	to	10	feet
1 1/2 x 4 ft. inch diameter	" " " " "	from	10	to	14	feet
inch diameter		from		to		feet

Describe and show depth of shoe, plug, adapter, liner or other details: None

9. Perforated Casings or Screens:

None	from		to	
(Number per foot and size of perforations, or describe screen)	from		to	
	from		to	
	from		to	

10. Log of Well: (Describe each stratum or formation clearly, indicate if water bearing, and give thickness and depth as indicated.)

MATERIAL	Thickness (Feet)	Depth to Bottom (Feet)
Black sticky clay	2	2
Yellow clay interspersed with water-bearing strata	12	14

If log of well is not available, give name and address of driller. _____

11. Infiltration Trench: Covered or open does not apply

Dimensions: Length _____ ft. Minimum depth _____ ft. Maximum depth _____ ft.

Bottom width _____ ft. Discharge _____ g.p.m. Date of test _____

12. Tunnel: Type of lining Does not apply

Dimensions: _____
(Length, course, and cross sectional size)

Position of water bearing stratum with reference to portal of tunnel _____

Log of tunnel: (Preceding table for log of well may be used, if desired. Give footage from portal and character of materials, as pertinent.)

13. Pumping Equipment:

(a) Pump 1 Fairbanks-Morse & 1 DeLaval Centrifugal in _____ series _____ Capacity 40 g.p.m.
(Make, type and size)

(b) Motor 2 Type "B" 5 H.P. each _____
(Type and horsepower)


14. Location of area irrigated or to be irrigated, or place of use if for purposes other than irrigation.

Township North or South	Range E. or W. of Willamette Meridian	Section	Forty-acre Tract	Number Acres To Be Irrigated	Date of Reclamation
37s	1W	19	SE $\frac{1}{4}$, SW $\frac{1}{4}$	40	1930

15. If the ground water supply is supplemental to an existing water supply, identification of any application for a permit, permit, certificate or adjudicated right to appropriate water made or held by the registrant.

None

Township 37 S. Range 1 W., W.M.
North

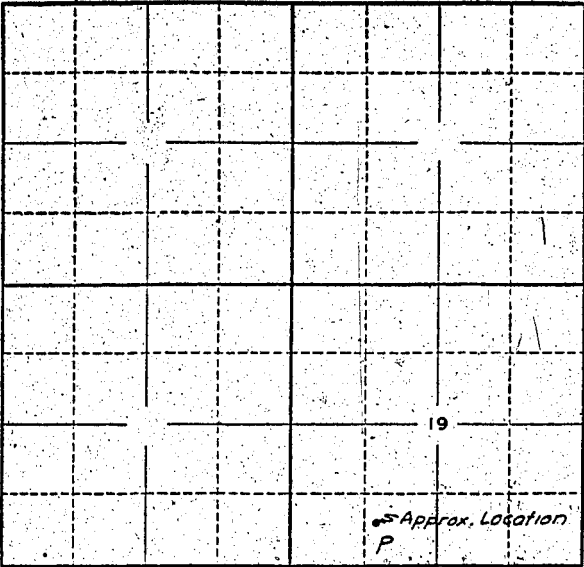

Locate well and acreage of irrigated land on plat.
Scale: 2" = 1 Mile

STATE OF OREGON

County of Jackson } ss.

I, J. C. Boyle, being first duly sworn, do hereby certify that I have read the foregoing Registration Statement and that all of the items therein contained are true to the best of my knowledge and belief.

(Signature of Registrant)

Vice President of The California Oregon Power

Subscribed and sworn to before me this 17th day of July, 1958 Company

My commission expires January 20, 1961

(Notary Public)

(SEAL)

CERTIFICATE OF REGISTRATION

STATE OF OREGON

County of Marion } ss.

This is to certify that the foregoing Registration Statement was received in the office of the State Engineer on the 22nd day of July, 1958, at 8:05 o'clock A. M. and has been duly recorded in said office in Book No. 10 of Registration Statements on page GR-2316

Witness my hand this 10th day of March, 1959

(State Engineer)

By _____ (Deputy)

\$ 15.00

GR-2316