

Registration Statement

OF CLAIMANT OF RIGHT TO APPROPRIATE GROUND WATER

RECEIVED
AUG 5 1966
STATE ENGINEER
OREGON

TO THE STATE ENGINEER OF OREGON:

I, Paul E. Wegener

of 5601 N.E. 133 Avenue, City of Portland, County of Multnomah
(Mailing address)

State of Oregon, do hereby make application for a certificate of registration as evidence of a right to appropriate ground water.

1. Source from which water is withdrawn is Electric pump well
(Flowing well, pump well, infiltration trench, or tunnel)

2. Location is: four miles from Portland, Oregon (East)
(Approximate distance and direction from nearest city or town)

and is more particularly described as follows:

(a) Lot 67, Plat 2, Reynolds Mountain View
(Give distance and bearing to corner of section or other legal subdivision)

being within of Sec. 14, Twp. 1 North, Rge. 2 East
(Smallest legal subdivision) (N. or S.) (E. or W.)

or (b) within limits of recorded platted property, town or city:

in Lot 67, Block Plat 2 of REYNOLDS MOUNTAIN VIEW
(Name of plat or addition)

County of Multnomah
(If within city or town, give name)

3. Construction Work was begun on 1948; was completed on 1948
(Date) (Date)

and the ground water claimed was first used for the purposes set out below on 1948
(Date)

since which time the water has been used Continuously during season
(Continuously or intermittently)

from 1948 to Present - 1966
(Date) (Date)

4. Quantity of water claimed and used is 60 gallons per minute; 1 1/2 acre feet per year.

5. Purpose or Purposes for which water is used ~~irrigation~~ and irrigation of domestic blueberries of 1 acre for abouts two months a year
(Domestic, irrigation, municipal, manufacturing, industrial, etc.)

6. Description of Well: Depth 40 feet. Type drilled
(Dug or drilled)

diameter six inches. Elevation of ground at well site 20 feet, mean sea level.
(As near as known)

Depth to water table unk feet.

7. Capacity of Well: g.p.m. with feet drawdown.

g.p.m. with feet drawdown.

Date of test 1948

If Flowing Well: Measured discharge g.p.m. on
(Date)

Shut-in pressure at ground surface lbs. per sq. in. on
(Date)

Water is controlled by
(Cap, valve, etc.)

8. Casing: (Give diameter, commercial specifications and depth below ground surface of each casing size.)

..... inch diameter *unk* from to feet
 inch diameter from to feet
 inch diameter from to feet
 inch diameter from to feet

Describe and show depth of shoe, plug, adapter, liner or other details:

.....

.....

9. Perforated Casings or Screens:

unk from to
 (Number per foot and size of perforations, or describe screen)
 from to
 from to
 from to

10. Log of Well: (Describe each stratum or formation clearly, indicate if water bearing, and give thickness and depth as indicated.)

MATERIAL	Thickness (Feet)	Depth to Bottom (Feet)
<i>well log not available</i>		

If log of well is not available, give name and address of driller.

11. Infiltration Trench: Covered or open
 Dimensions: Length ft. Minimum depth ft. Maximum depth ft.
 Bottom width ft. Discharge g.p.m. Date of test

12. Tunnel: Type of lining
 Dimensions:
(Length, course, and cross sectional size)
 Position of water bearing stratum with reference to portal of tunnel

Log of tunnel: (Preceding table for log of well may be used, if desired. Give footage from portal and character of materials, as pertinent.)



13. Pumping Equipment:
 (a) Pump *Turbine* Capacity *60* g.p.m.
(Make, type and size)
 (b) Motor
(Type and horsepower)

14. Location of area irrigated or to be irrigated, or place of use if for purposes other than irrigation.

Township North or South	Range E. or W. of Willamette Meridian	Section	Forty-acre Tract	Number Acres To Be Irrigated	Date of Reclamation
t. 1N.	R. 2E.	14	SE 1/4 & SE 1/4	one acre	1948

15. If the ground water supply is supplemental to an existing water supply, identification of any application for a permit, permit, certificate or adjudicated right to appropriate water made or held by the registrant.

Township 1 N Range 2 E, W.M.
North

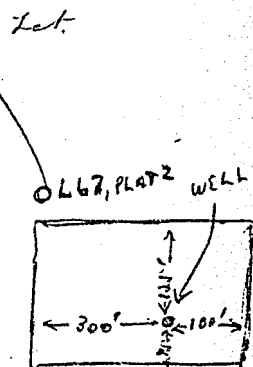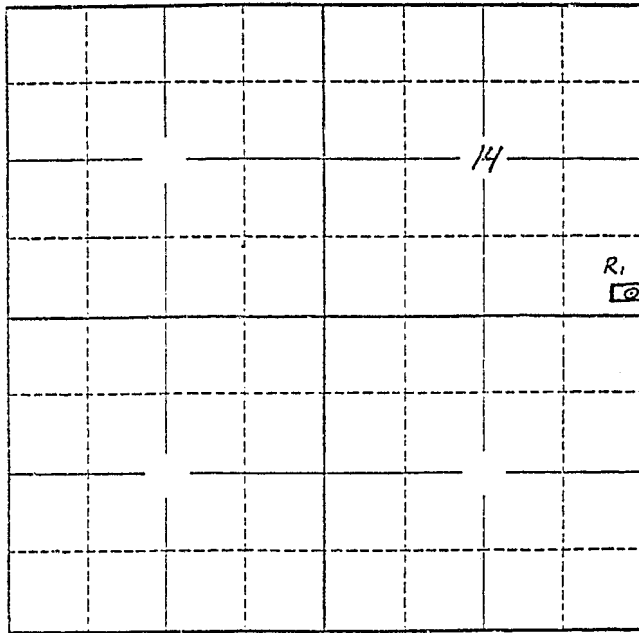

Locate well and a creage of irrigated land on plat.
Scale: 2" = 1 Mile

STATE OF OREGON

County of Multnomah } ss.

I, Paul E. Wegener, being first duly sworn, do hereby certify that I have read the foregoing Registration Statement and that all of the items therein contained are true to the best of my knowledge and belief.

Paul E. Wegener
(Signature of Registrant)

Subscribed and sworn to before me this 3 day of AUGUST, 1966

My commission expires Nov. 19, 1968

Sherran H. Salmer
(Notary Public)

(SEAL)

CERTIFICATE OF REGISTRATION

STATE OF OREGON }
County of Marion } ss.

*This statement filed in lieu of original statement which was lost.
Sept. 1966. WSB. Original statement filed 7/22/58 WSB.*

This is to certify that the foregoing Registration Statement was received in the office of the State Engineer on the 5th day of August, 1966, at 2:00 o'clock A. M. and has been duly recorded in said office in Book No. 17 of Registration Statements on page GR-4157

Witness my hand this 31st day of October, 1967

[Signature]
(State Engineer)

By _____
(Deputy)