

# Registration Statement

## OF CLAIMANT OF RIGHT TO APPROPRIATE GROUND WATER

TO THE STATE ENGINEER OF OREGON:

I, Willard and Dorothy Stapler

of Route 3, Box 1082, Albany

County of Linn

State of Oregon

do hereby make application for a certificate of registration as evidence of a right to appropriate ground water.

1. Source from which water is withdrawn is pump well

(Flowing well, pump well, infiltration trench, or tunnel)

2. Location is: five miles south of Albany, Oregon

(Approximate distance and direction from nearest city or town)

and is more particularly described as follows:

(a) 1254' S. and 1914' W. of NE corner S. 5, T. 123, R. 37

(Give distance and bearing to corner of section or other legal subdivision)

being within NE 1/4 of NE 1/4

(Smallest legal subdivision)

of Sec. 5

Twp. 123

Rge. 37

(N. or S.)

(E. or W.)

or (b) within limits of recorded platted property, town or city:

in Lot \_\_\_\_\_, Block \_\_\_\_\_ of \_\_\_\_\_

(Name of plat or addition)

County of Linn

(If within city or town, give name)

3. Construction Work was begun on 1951

(Date)

; was completed on Feb. 2, 1951

(Date)

and the ground water claimed was first used for the purposes set out below on June, 1951

(Date)

since which time the water has been used continuously

(Continuously or intermittently)

from June, 1951 to present time

(Date)

(Date)

4. Quantity of water claimed and used is 150 gallons per minute; 33 acre feet per year.

5. Purpose or Purposes for which water is used: Irrigation

(Domestic, irrigation, municipal, manufacturing, industrial, etc.)

6. Description of Well: Depth 95 feet. Type Drilled

(Dug or drilled)

diameter 9 inches. Elevation of ground at well site 320 feet, mean sea level.

(As near as known)

Depth to water table 30 feet.

7. Capacity of Well: \_\_\_\_\_ g.p.m. with \_\_\_\_\_ feet drawdown.

\_\_\_\_\_ g.p.m. with \_\_\_\_\_ feet drawdown.

Date of test \_\_\_\_\_

If Flowing Well: Measured discharge \_\_\_\_\_ g.p.m. on \_\_\_\_\_

(Date)

Shut-in pressure at ground surface \_\_\_\_\_ lbs. per sq. in. on \_\_\_\_\_

(Date)

Water is controlled by \_\_\_\_\_

(Cap, valve, etc.)

8. Casing: (Give diameter, commercial specifications and depth below ground surface of each casing size.)

8 inch diameter Steel casing from 0 to 90.19 feet  
 inch diameter from to feet  
 inch diameter from to feet  
 inch diameter from to feet

Describe and show depth of shoe, plug, adapter, liner or other details:

9. Perforated Casings or Screens:

Slot perforations from 67 to 90  
 (Number per foot and size of perforations, or describe screen)  
 from to  
 from to  
 from to

10. Log of Well: (Describe each stratum or formation clearly, indicate if water bearing, and give thickness and depth as indicated.)

MATERIAL	Thickness (Feet)	Depth to Bottom (Feet)
Clay	12	12
Clay and Boulders	16	28
Clay and Gravel	17	45
Sand and Clay	7	52
Gravel and Clay	12	64
Sand, Gravel and Clay	22	86
Sand and Gravel	9	95

If log of well is not available, give name and address of driller. \_\_\_\_\_

**11. Infiltration Trench: Covered or open** \_\_\_\_\_

Dimensions: Length \_\_\_\_\_ ft. Minimum depth \_\_\_\_\_ ft. Maximum depth \_\_\_\_\_ ft.

Bottom width \_\_\_\_\_ ft. Discharge \_\_\_\_\_ g.p.m. Date of test \_\_\_\_\_

**12. Tunnel: Type of lining** \_\_\_\_\_

Dimensions: \_\_\_\_\_  
(Length, course, and cross sectional size)

Position of water bearing stratum with reference to portal of tunnel \_\_\_\_\_

Log of tunnel: (Preceding table for log of well may be used, if desired. Give footage from portal and character of materials, as pertinent.) \_\_\_\_\_

**13. Pumping Equipment:**

(a) Pump Deep well turbine \_\_\_\_\_ Capacity 150 g.p.m.  
(Make, type and size)


(b) Motor 5 H.P. electric \_\_\_\_\_  
(Type and horsepower)

**14. Location of area irrigated or to be irrigated, or place of use if for purposes other than irrigation.**

Township North or South	Range E. or W. of Willamette Meridian	Section	Forty-acre Tract	Number Acres To Be Irrigated	Date of Reclamation
12S	3W	5	NW $\frac{1}{4}$ of NE $\frac{1}{4}$	6.0	June, 1951
12S	3W	5	SW $\frac{1}{4}$ of NE $\frac{1}{4}$	5.0	June, 1951
				11.0	

15. If the ground water supply is supplemental to an existing water supply, identification of any application for a permit, permit, certificate or adjudicated right to appropriate water made or held by the registrant. \_\_\_\_\_

Township 12S Range 3W, W.M.  
North

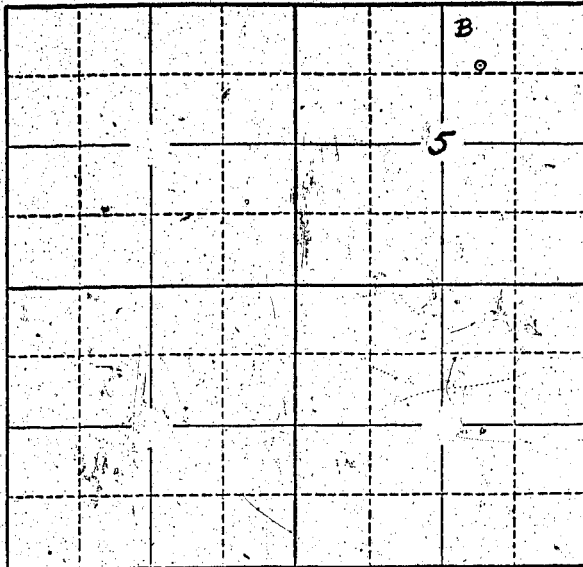

Locate well and acreage of irrigated land on plat.  
Scale: 2" = 1 Mile

STATE OF OREGON

County of Linn } ss.

I, Willard and Dorothy Stapler, being first duly sworn, do hereby certify that I have read the foregoing Registration Statement and that all of the items therein contained are true to the best of my knowledge and belief.

(Signature of Registrant)

Subscribed and sworn to before me this \_\_\_\_\_ day of \_\_\_\_\_, 19\_\_\_\_\_

My commission expires MY COMMISSION EXPIRES MAY 22, 1962

(Notary Public)

(SEAL)

CERTIFICATE OF REGISTRATION

STATE OF OREGON

County of Marion } ss.

This is to certify that the foregoing Registration Statement was received in the office of the State Engineer on the 22<sup>nd</sup> day of July, 1959, at 6:00 o'clock A.M. and has been duly recorded in said office in Book No. 10 of Registration Statements on page GR-2318

Witness my hand this 10<sup>th</sup> day of March, 1959

*Lewis A. Stanley*  
(State Engineer)

By \_\_\_\_\_ (Deputy)

GR-2318

15.00  
7