

RECEIVED  
AUG 3 1956

STATE ENGINEER  
SALEM, OREGON

# Registration Statement

OF CLAIMANT OF RIGHT TO APPROPRIATE GROUND WATER NO. GR-245

(Under Chapter 708, Oregon Laws 1955.) CERTIFICATE NO. GR-221

24-7c(1)

TO THE STATE ENGINEER OF OREGON:

I, GLEN T. SCHAEFFER /<sup>AND</sup> OR BERNICE B. SCHAEFFER  
of RT. 3 Box 225A, BORING County of CLACKAMAS

State of OREGON do hereby make application for a certificate of registration as evidence of a right to appropriate ground water.

- 1. Source from which water is withdrawn is PUMP WELL  
(Flowing well, pump well, infiltration trench, or tunnel)
- 2. Location is: 1 MILE SE BORING  
(Approximate distance and direction from nearest city or town)

and is more particularly described as follows:

(a) APPROX 2100' N & 510' W OF CENTER OF SEC 7 25 4E  
(Give distance and bearing to corner of section or other legal subdivision)  
being within E 1/4 OF NW 1/4 of Sec. 7, Twp. 23, Rge. 4E WM  
(Smallest legal subdivision) (N. or S.) (E. or W.)

or (b) within limits of recorded platted property, town or city: \_\_\_\_\_  
in Lot \_\_\_\_\_, Block \_\_\_\_\_ of \_\_\_\_\_  
(Name of plat or addition)

County of CLACKAMAS  
(If within city or town, give name)

3. Construction Work was begun on JUNE 1951; was completed on AUG 1951  
(Date) (Date)

and the ground water claimed was first used for the purposes set out below on AUG 25 1951  
(Date)  
since which time the water has been used CONTINUOUSLY (FOR IRRIGATION)  
(Continuously or Intermittently)  
from SEPT 1 1951 to AUG 1956  
(Date) (Date)

4. Quantity of water claimed and used is 500 gallons per minute; \_\_\_\_\_ acre feet per year.

5. Purpose or Purposes for which water is used IRRIGATION & DOMESTIC  
(Domestic, irrigation, municipal, manufacturing, industrial, etc.)

6. Description of Well: Depth 255 feet. Type DRILLED  
(Dug or drilled)  
diameter 12" inches. Elevation of ground at well site 600' feet, mean sea level.  
(As near as known)  
Depth to water table 170 feet.

7. Capacity of Well: 1500 g.p.m. with 8' feet drawdown.  
\_\_\_\_\_ g.p.m. with \_\_\_\_\_ feet drawdown.

Date of test AUG 1951

If Flowing Well: Measured discharge \_\_\_\_\_ g.p.m. on \_\_\_\_\_  
(Date)

Shut-in pressure at ground surface \_\_\_\_\_ lbs. per sq. in. on \_\_\_\_\_  
(Date)

Water is controlled by \_\_\_\_\_  
(Cap, valve, etc.)

8. Casing: (Give diameter, commercial specifications and depth below ground surface of each casing size.)

12" inch diameter ..... from GROUND to 259' feet  
 ..... inch diameter ..... from ..... to ..... feet  
 ..... inch diameter ..... from ..... to ..... feet  
 ..... inch diameter ..... from ..... to ..... feet

Describe and show depth of shoe, plug, adapter, liner or other details: SHOE AT 259'  
PLUGGED IN BLACK SAND

9. Perforated Casings or Screens:

16 PER FT.  $\frac{3}{16}$  x  $\frac{1}{4}$  ..... from 230' to 252'  
(Number per foot and size of perforations, or describe screen)  
 ..... from ..... to .....  
 ..... from ..... to .....  
 ..... from ..... to .....

10. Log of Well: (Describe each stratum or formation clearly, indicate if water bearing, and give thickness and depth as indicated.)

MATERIAL	Thickness (Feet)	Depth to Bottom (Feet)
LOAM	2	2
RED CLAY	10	12
MOTTLED CLAY	65	75
CEMENT GRAVEL LOTTEN ROCK	150	225
ROCK	2	227
GRAVEL CLEAN, ROUND, HTD	31	258
BLACK COURSE SAND	1	259

If log of well is not available, give name and address of driller. ....

11. Infiltration Trench: Covered or open .....

Dimensions: Length ..... ft. Minimum depth ..... ft. Maximum depth ..... ft.

Bottom width ..... ft. Discharge ..... g.p.m. Date of test .....

12. Tunnel: Type of lining .....

Dimensions: .....  
(Length, course, and cross sectional size)

Position of water bearing stratum with reference to portal of tunnel .....

Log of tunnel: (Preceding table for log of well may be used, if desired. Give footage from portal and character of materials, as pertinent.)

13. Pumping Equipment:

(a) Pump WESTERN LAND ROLLER Capacity 800 g.p.m.  
(Make, type and size)

(b) Motor U.S. ELECTRIC 40 HP  
(Type and horsepower)


14. Location of area irrigated or to be irrigated, or place of use if for purposes other than irrigation.

Township North or South	Range E. or W. of Williams Meridian	Section	Forty-acre Tract	Number Acres To Be Irrigated	Date of Reclamation
T23	4E	SEC 7		106 Total	June 1951
"	"	"	NE 1/4 of NW 1/4	28	" "
"	"	"	SE 1/4 of NW 1/4	21	" "
"	"	"	SW 1/4 of NE 1/4	25	" "
"	"	"	NE 1/4 of SW 1/4	21	" "
"	"	"	SE 1/4 of SW 1/4	8	" "
"	"	"	NW 1/4 of SE 1/4	3	" "
				106	

15. If the ground water supply is supplemental to an existing water supply, identification of any application for a permit, permit, certificate or adjudicated right to appropriate water made or held by the registrant.

Township 23 Range 4E W.M.  
North BOEING

OREGON CITY RD  
KELSO →

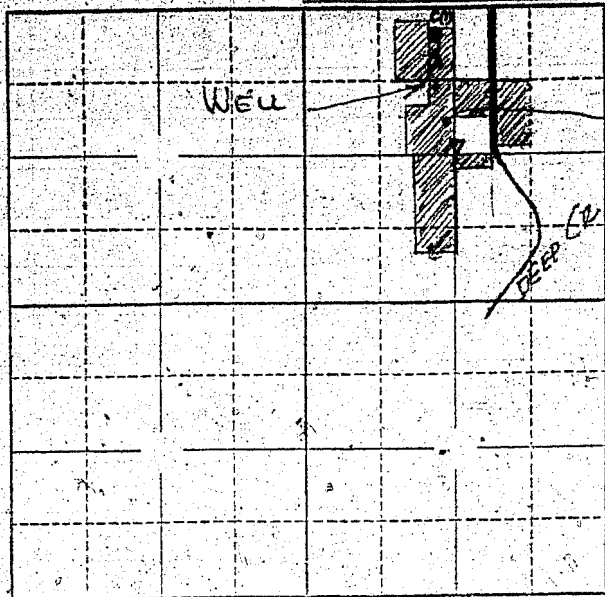

NOTE —  
DRY 12" hole  
drilled 400'  
deep 1951

Locate well and acreage of irrigated land on plat.  
Scale: 2" = 1 Mile

STATE OF OREGON

County of Multnomah } ss.

I, Glen T. Schaeffer being first duly sworn, do hereby certify that I have read the foregoing Registration Statement and that all of the items therein contained are true to the best of my knowledge and belief.

Glen T. Schaeffer  
(Signature of Registrant)

Subscribed and sworn to before me this 2<sup>nd</sup> day of August, 1956

My commission expires June 18, 1957

[Signature]  
(Notary Public)

(SEAL)

### CERTIFICATE OF REGISTRATION

STATE OF OREGON

County of Marion } ss.

This is to certify that the foregoing Registration Statement was received in the office of the State Engineer on the 28th day of August, 1956, at 8 o'clock A. M. and has been duly recorded in said office in Book No. 2 of Registration Statements on page GR-221 C.

~~Construction work to be completed by X-X-X-X-X-X-X-X-X-X-X-X and the water completely applied to~~  
~~benefit of X-X-X-X-X-X-X-X-X-X-X-X~~

Witness my hand this 23rd day of November, 1956.

Lynn A. Stanley  
(State Engineer)

By \_\_\_\_\_ (Deputy)

GR-221 C