

Registration No. GR-2450

Certificate No. GR-2322

Registration Statement

OF CLAIMANT OF RIGHT TO APPROPRIATE GROUND WATER

TO THE STATE ENGINEER OF OREGON:

I, Thos M Mc Gill
of Junction City Oregon - RTH 2 County of Lane
(Mailing address)

State of Oregon, do hereby make application for a certificate of registration as evidence of a right to appropriate ground water.

1. Source from which water is withdrawn is Dump Well
(Flowing well, pump well, infiltration trench, or tunnel)

2. Location is: 1 mile S E Junction City
(Approximate distance and direction from nearest city or town)

and is more particularly described as follows:

(a) 1600' N. & 2325' E. from S.W. Cor. S4S 33
(Give distance and bearing to corner of section or other legal subdivision)

being within N.E. 1/4 of S.W. 1/4 of Sec. 33, Twp. 15-3, Rge. 4-4
(Smallest legal subdivision) (N. or S.) (E. or W.)

or (b) within limits of recorded platted property, town or city:

in Lot _____, Block _____ of _____
(Name of plat or addition)

County of Lane
(If within city or town, give name)

3. Construction Work was begun on 1953; was completed on 1953
(Date) (Date)

and the ground water claimed was first used for the purposes set out below on 1953
(Date)

since which time the water has been used Intermittently
(Continuously or intermittently)

from May to Sept
(Date) (Date)

4. Quantity of water claimed and used is 300 gallons per minute; 60 acre feet per year.

5. Purpose or Purposes for which water is used Irrigation

(Domestic, irrigation, municipal, manufacturing, industrial, etc.)

6. Description of Well: Depth 30 feet. Type Drilled
(Dug or drilled)

diameter 8 inches. Elevation of ground at well site 317 feet, mean sea level.
(As near as known)

Depth to water table 8 feet.

7. Capacity of Well: 600 g.p.m. with 4 feet drawdown.

_____ g.p.m. with _____ feet drawdown.


Date of test 1953

If Flowing Well: Measured discharge _____ g.p.m. on _____
(Date)

Shut-in pressure at ground surface _____ lbs. per sq. in. on _____
(Date)

Water is controlled by _____
(Cap, valve, etc.)

Township 15S Range 4W, W.M.
North

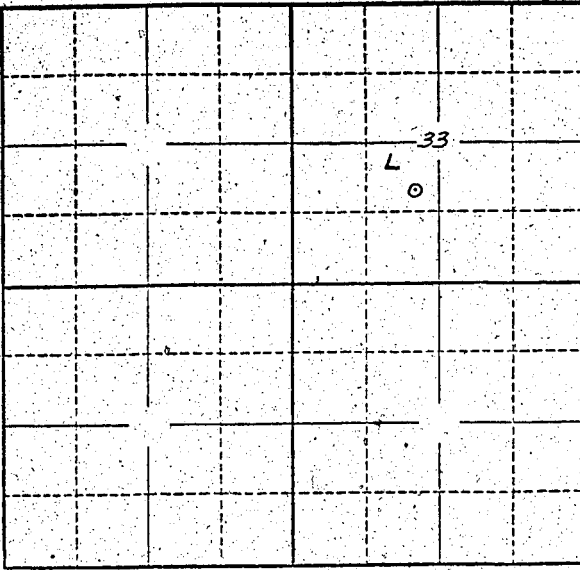

Locate well and acreage of irrigated land on plat.
Scale: 2" = 1 Mile

STATE OF OREGON }
County of Marion } ss.


(Signature of Registrant)

Subscribed and sworn to before me this 10 day of March, 1959.

My commission expires August 1, 1960
(Notary Public)

(SEAL)

CERTIFICATE OF REGISTRATION

STATE OF OREGON }
County of Marion } ss.

This is to certify that the foregoing Registration Statement was received in the office of the State Engineer on the 22 day of July, 1958, at 8:00 o'clock A. M. and has been duly recorded in said office in Book No. 10 of Registration Statements on page GR 2322

Witness my hand this 10th day of March, 1959
George W. Stanley
(State Engineer)

\$1500

By _____
(Deputy)