

RECEIVED  
JUL 22 1958

Registration No. GR. 2455  
Certificate No. GR. 2326

# Registration Statement

STATE ENGINEER  
SALEM, OREGON

## OF CLAIMANT OF RIGHT TO APPROPRIATE GROUND WATER

TO THE STATE ENGINEER OF OREGON:

I, Swander Brothers

of Route 2, Box 234, Lebanon County of Linn  
(Mailing address)

State of Oregon, do hereby make application for a certificate of registration as evidence of a right to appropriate ground water.

1. Source from which water is withdrawn is ump well #2  
(Flowing well, pump well, infiltration trench, or tunnel)

2. Location is: four miles NE of Lebanon, Oregon  
(Approximate distance and direction from nearest city or town)

and is more particularly described as follows:

(a) 2277' N. and 1749' W. of SE corner S. 15, T 11S, R 2W.  
(Give distance and bearing to corner of section or other legal subdivision)

being within NW 1/4 of SE of Sec. 15, Twp. 11S, Rge. 2W  
(Smallest legal subdivision) (N. or S.) (E. or W.)

or (b) within limits of recorded platted property, town or city:

in Lot \_\_\_\_\_, Block \_\_\_\_\_ of \_\_\_\_\_  
(Name of plat or addition)

County of Linn  
(If within city or town, give name)

3. Construction Work was begun on May 30, 1952; was completed on June, 1952  
(Date) (Date)

and the ground water claimed was first used for the purposes set out below on June, 1952  
(Date)

since which time the water has been used continuously  
(Continuously or intermittently)

from June, 1952 to present time  
(Date) (Date)

4. Quantity of water claimed and used is 260 gallons per minute; 75.0 acre feet per year.

5. Purpose or Purposes for which water is used Irrigation

(Domestic, irrigation, municipal, manufacturing, industrial, etc.)

6. Description of Well: Depth 21 feet, Type Drilled  
(Dug or drilled)

diameter 8 inches. Elevation of ground at well site 290 feet, mean sea level.  
(As near as known)

Depth to water table 11 feet.

7. Capacity of Well: 350 g.p.m. with 1 feet drawdown.

\_\_\_\_\_ g.p.m. with \_\_\_\_\_ feet drawdown.

Date of test June, 1952

If Flowing Well: Measured discharge \_\_\_\_\_ g.p.m. on \_\_\_\_\_  
(Date)


Shut-in-pressure at ground surface \_\_\_\_\_ lbs. per sq. in. on \_\_\_\_\_  
(Date)

Water is controlled by \_\_\_\_\_  
(Cap, valve, etc.)





Township 11S Range 2W W.M.  
North

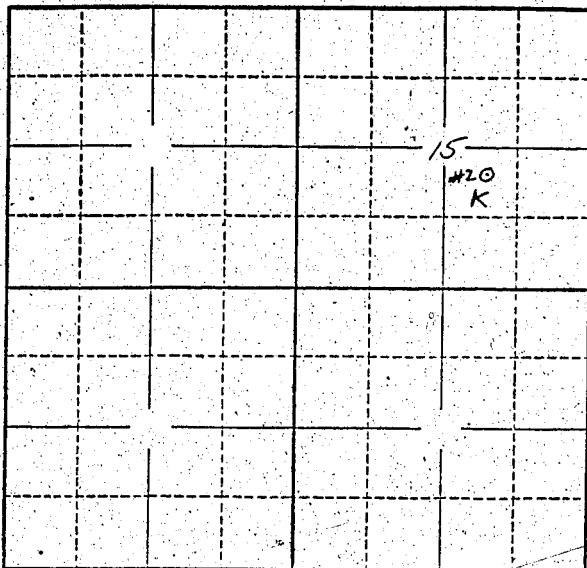

Locate well and acreage of irrigated land on plat.

Scale: 2" = 1 Mile

STATE OF OREGON

County of Linn } ss.

I, Swander Brothers, being first duly sworn, do hereby certify that I have read the foregoing Registration Statement and that all of the items therein contained are true to the best of my knowledge and belief.

*Swander Brothers*  
(Signature of Registrant)

Subscribed and sworn to before me this 18th day of JULY, 1958.

My commission expires JAN. 29, 1962

*Jane Piper*  
(Notary Public)

(SEAL)

CERTIFICATE OF REGISTRATION

STATE OF OREGON } ss.  
County of Marion

This is to certify that the foregoing Registration Statement was received in the office of the State Engineer on the 22nd day of July, 1958, at 2:00 o'clock A.M. and has been duly recorded in said office in Book No. 10 of Registration Statements on page GR-2326

Witness my hand this 10th day of March, 1959

*Laura A. Stanley*  
(State Engineer)

\$1500

By \_\_\_\_\_ (Deputy)