

RECEIVED  
JUL 27 1958  
STATE ENGINEER  
SALEM, OREGON

REGISTRATION NO. GR-2459  
CERTIFICATE NO. GR-2330

# Registration Statement

## OF CLAIMANT OF RIGHT TO APPROPRIATE GROUND WATER

(Under Chapter 708, Oregon Laws 1955.)

TO THE STATE ENGINEER OF OREGON:

I, Ellis & Lois Walker

of Route 1, Box 423, Corvallis County of Benton

State of Oregon do hereby make application for a certificate of registration as evidence of a right to appropriate ground water.

1. Source from which water is withdrawn is pump well

(Flowing well, pump well, infiltration trench, or tunnel)

2. Location is: 4 miles NE of Corvallis

(Approximate distance and direction from nearest city or town)

and is more particularly described as follows: 142' N 25° 30' W of 1" solid iron axle, said

1640 ft. well 760 feet from SE. Cor. Sec. 18.

(a) axle locating the SE corner of property located in

(Give distance and bearing to corner of section or other legal subdivision)

being within .SW<sup>1</sup> SE<sup>1</sup> of Sec. 18, Twp. 11 S, Rge. 1 W

(Smallest legal subdivision)

(N. or S.)

(E. or W.)

or (b) within limits of recorded platted property, town or city:

in Lot \_\_\_\_\_, Block \_\_\_\_\_ of \_\_\_\_\_

(Name of plat or addition)

County of \_\_\_\_\_

(If within city or town, give name)

3. Construction Work was begun on April 13, 1954; was completed on April, 1954

(Date)

(Date)

and the ground water claimed was first used for the purposes set out below on 1954

(Date)

since which time the water has been used continuously

(Continuously or intermittently)

from 1954 to 1957

(Date)

(Date)

4. Quantity of water claimed and used is 15 gallons per minute; 5 acre feet per year.

5. Purpose or Purposes for which water is used irrigation including 1/2 acre greenhouse

(Domestic, irrigation, municipal, manufacturing, industrial, etc.)

6. Description of Well: Depth 54 feet. Type drilled

(Dug or drilled)

diameter 6 inches. Elevation of ground at well site 225 feet, mean sea level.

(As near as known)

Depth to water table 22 feet.

7. Capacity of Well: 45 g.p.m. with 4 feet drawdown.

\_\_\_\_\_ g.p.m. with \_\_\_\_\_ feet drawdown.

Date of test 1954

If Flowing Well: Measured discharge \_\_\_\_\_ g.p.m. on \_\_\_\_\_

(Date)

Shut-in pressure at ground surface \_\_\_\_\_ lbs. per sq. in. on \_\_\_\_\_

(Date)

Water is controlled by \_\_\_\_\_

(Gate, valve, etc.)



If log of well is not available, give name and address of driller. Raymond Gellatly, Philomath

**11. Infiltration Trench: Covered or open** .....

Dimensions: Length ..... ft. Minimum depth ..... ft. Maximum depth ..... ft.

Bottom width ..... ft. Discharge ..... g.p.m. Date of test .....

**12. Tunnel: Type of lining** .....

Dimensions: .....  
(Length, course, and cross sectional size)

Position of water bearing stratum with reference to portal of tunnel .....

Log of tunnel: (Preceding table for log of well may be used, if desired. Give footage from portal and character of materials, as pertinent.)

**13. Pumping Equipment:**

(a) Pump Fairbanks Morse centrifugal jet boost. 1 1/2" x 2" Capacity 45 g.p.m.  
(Make, type and size)


(b) Motor 2 hp electric single phase  
(Type and horsepower)

**14. Location of area irrigated or to be irrigated, or place of use if for purposes other than irrigation.**

Township North or South	Range E. or W. of Willamette Meridian	Section	Forty-acre Tract	Number Acres To Be Irrigated	Date of Reclamation
11 S	1W	18	SW 1/4 SE 1/4	2.0	1954

15. If the ground water supply is supplemental to an existing water supply, identification of any application for a permit, permit, certificate or adjudicated right to appropriate water made or held by the registrant.

Township 11.5 Range 11.41, W.M.  
North

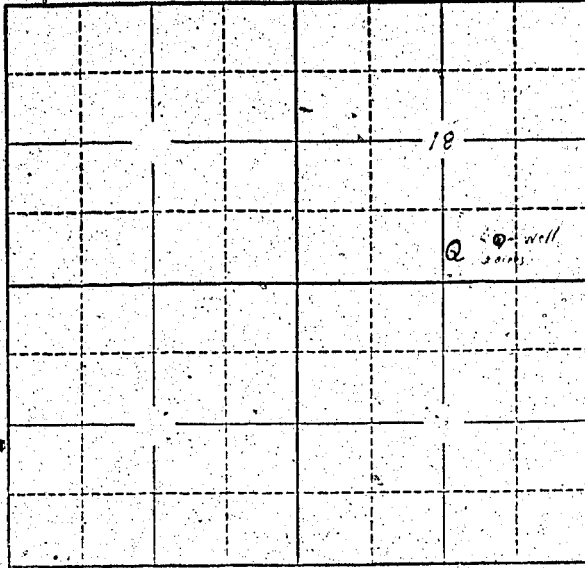

Locate well and acreage of irrigated land on plat.  
Scale: 2" = 1 Mile

STATE OF OREGON }  
County of Douglas } ss.

I, Ellen Walker, being first duly sworn, do hereby certify that I have read the foregoing Registration Statement and that all of the items therein contained are true to the best of my knowledge and belief.

Ellen Walker  
(Signature of Registrant)

Subscribed and sworn to before me this 21 day of July, 1958

My commission expires \_\_\_\_\_  
(Notary Public)

(SEAL) My Commission Expires \_\_\_\_\_

**CERTIFICATE OF REGISTRATION**

STATE OF OREGON }  
County of Marion } ss.

This is to certify that the foregoing Registration Statement was received in the office of the State Engineer on the 22 day of July, 1958, at 8.00 o'clock A. M. and has been duly recorded in said office in Book No. 10 of Registration Statements on page GR-2330

~~Construction shall be completed by \_\_\_\_\_ and the same completely completed for beneficial use by \_\_\_\_\_~~

Witness my hand this 10<sup>th</sup> day of March, 1959  
Leona A. Stanley  
(State Engineer)

\$1,500

By \_\_\_\_\_  
(Deputy)

GR-2330