

RECEIVED
JUL 22 1958

STATE ENGINEER
SALEM, OREGON

RECEIVED
JAN 19 1960

STATE ENGINEER
SALEM, OREGON

Registration No. GR - 2461

Certificate No. GR 3923

Registration Statement

OF CLAIMANT OF RIGHT TO APPROPRIATE GROUND WATER

TO THE STATE ENGINEER OF OREGON:

I, Frank E. Fox

of Rt 2 Box 362 Corvallis County of Benton

State of Oregon, do hereby make application for a certificate of registration as evidence of a right to appropriate ground water.

1. Source from which water is withdrawn is Pump Well
(Flowing well, pump well, infiltration trench, or tunnel)

2. Location is: 1/2 mi west on Hwy 50 of Corvallis
(Approximate distance and direction from nearest city or town)

and is more particularly described as follows: 850 feet west & 270 feet north from E 1/4 corner Section 4.

(a) 1040' to NE Cor 0142 95' S Hwy 5 line
(Give distance and bearing to corner of section or other legal subdivision)

being within PRIER Scott DL 44 of Sec. 4, Twp. 12 S, Rge. 5W
(Smallest legal subdivision)

or (b) within limits of recorded platted property, town or city:

in Lot _____, Block _____ of _____
(Name of plat or addition)

County of _____
(If within city or town, give name)

3. Construction Work was begun on Sept 5 - 1950; was completed on Sept 6 - 1950
(Date)

and the ground water claimed was first used for the purposes set out below on Sept 24 - 1950
(Date)

since which time the water has been used intermittently
(Continuously or intermittently)

from Sept 1950 to Aug 1958
(Date)

4. Quantity of water claimed and used is 4.5 gallons per minute; _____ acre feet per year.

5. Purpose or Purposes for which water is used Irrigate pasture - orchard
(Domestic, irrigation, municipal, manufacturing, industrial, etc.)
exempt
water stock

6. Description of Well: Depth 57 feet. Type Drilled
(Dug or drilled)

diameter 6 inches. Elevation of ground at well site _____ feet, mean sea level.
(As near as known)

Depth to water table _____ feet.

7. Capacity of Well: 4.5 g.p.m. with _____ feet drawdown.
Run 3 and sometimes for sprinklers at a time.
_____ g.p.m. with _____ feet drawdown.

Date of test _____

If Flowing Well: Measured discharge _____ g.p.m. on _____
(Date)

Shut-in pressure at ground surface _____ lbs. per sq. in. on _____
(Date)

Water is controlled by _____
(Cap, valve, etc.)

Pump flow according to well test by the drilled (Frank Skillings Corvallis) is 45 gal per min. I temporarily put in a 1 HP pump with the expectation of changing to 2 HP.

If log of well is not available, give name and address of driller. Stilling
Corvallis Oregon

11. Infiltration Trench: Covered or open _____
 Dimensions: Length _____ ft. Minimum depth _____ ft. Maximum depth _____ ft.
 Bottom width _____ ft. Discharge _____ g.p.m. Date of test _____

12. Tunnel: Type of lining _____
 Dimensions: _____
(Length, course, and cross sectional size)
 Position of water bearing stratum with reference to portal of tunnel _____

Log of tunnel: (Preceding table for log of well may be used, if desired. Give footage from portal and character of materials, as pertinent.)


13. Pumping Equipment:
 (a) Pump Fairbanks Morse Capacity 40 g.p.m.
(Make, type and size)
 (b) Motor JET 1HP to be 2 at present
(Type and horsepower) 1.1 HP

14. Location of area irrigated or to be irrigated, or place of use if for purposes other than irrigation.

Township North or South	Range E. or W. of Willamette Meridian	Section	Forty-acre Tract	Number Acres To Be Irrigated	Date of Reclamation
<u>T12S</u>	<u>R5W</u>	<u>4</u>	<u>SE 1/4 of NE 1/4 Hor Scott D.L.C #44</u>	<u>5.12</u> Ac	<u>1950</u>
			<u>in Benton County NE 1/4 of SE 1/4</u>	<u>2.00</u> Ac	
				<u>7.12</u> Ac	

15. If the ground water supply is supplemental to an existing water supply, identification of any application for a permit, permit, certificate or adjudicated right to appropriate water made or held by the registrant.
yes

Township 12S Range R5W, W.M.
North

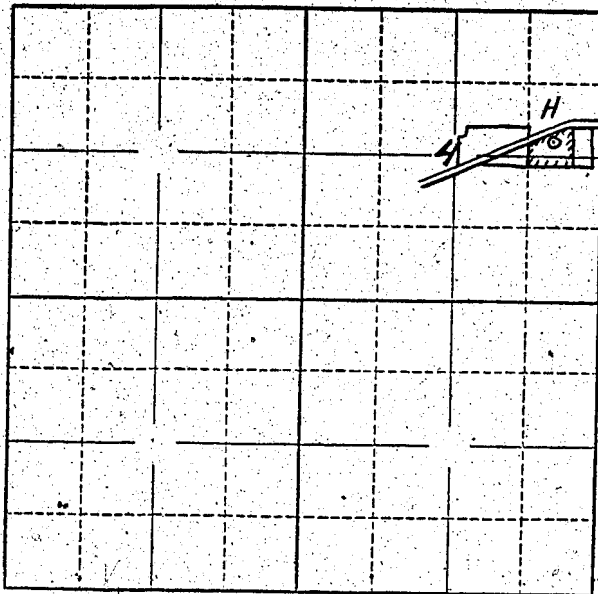

Locate well and acreage of irrigated land on plat.
Scale: 2" = 1 Mile

STATE OF OREGON

County of _____

} ss.

I, FRANK E FOX, being first duly sworn, do hereby certify that I have read the foregoing Registration Statement and that all of the items therein contained are true to the best of my knowledge and belief.

[Signature]
(Signature of Registrant)

Subscribed and sworn to before me this 21st day of July, 1958

My commission expires Oct 5, 1958
(Notary Public)

(SEAL)

CERTIFICATE OF REGISTRATION

STATE OF OREGON

County of Marlon

} ss.

This is to certify that the foregoing Registration Statement was received in the office of the State Engineer on the 22 day of July, 1958, at 8:00 o'clock A. M. and has been duly recorded in said office in Book No. 16 of Registration Statements on page GR-3923

Witness my hand this 15th day of February, 1960

[Signature]
(State Engineer)

By _____
(Deputy)

GR 3923

#1500