

RECEIVED
JUL 23 1958

STATE ENGINEER
SALEM, OREGON

Registration No. GR - 2462

Certificate No. GR - 2332

Registration Statement

OF CLAIMANT OF RIGHT TO APPROPRIATE GROUND WATER

TO THE STATE ENGINEER OF OREGON:

I, Frank Shelley

of Rte 2 Box 737 Creswell County of Lane

State of Oregon, do hereby make application for a certificate of registration as evidence of a right to appropriate ground water.

1. Source from which water is withdrawn is (pond) pump well
(Flowing well, pump well, infiltration trench, or tunnel)

2. Location is: 10 miles South East of Springfield
(Approximate distance and direction from nearest city or town)

and is more particularly described as follows: beginning at the N.E. corner of the John Russel Donstion Land Claim No. 72 thence south 56.99

(a) chains thence west 9.09 chains to pond. 100 ft. North & 200 feet west from N.E. cor.
(Give distance and bearing to corner of section or other legal subdivision)

being within SE 1/4 of SW 1/4 claim no. 72 of Sec. 22, Twp. 13S, Rge. 2W
(Smallest legal subdivision) (N. or S.) (E. or W.)

or (b) within limits of recorded platted property, town or city:

in Lot _____, Block _____ of _____
(Name of plat or addition)

County of _____
(if within city or town, give name)

3. Construction Work was begun on June 1, 1951; was completed on June 4, 1951
(Date) (Date)

and the ground water claimed was first used for the purposes set out below on June 1952
(Date)

since which time the water has been used each summer, intermittently
(Continuously or intermittently)

from May to September
(Date) (Date)

4. Quantity of water claimed and used is 50 gallons per minute; 100 acre feet per year.

5. Purpose or Purposes for which water is used Irrigation

(Domestic, irrigation, municipal, manufacturing, industrial, etc.)

6. Description of Well: Depth 12 feet. Type Dug (open well)
(Dug or drilled)

diameter 24 inches 35' long. Elevation of ground at well site 535 feet, mean sea level.
(As near as known)

Depth to water table 12 feet.

7. Capacity of Well: 500 g.p.m. with 3 feet drawdown.

500 g.p.m. with 5 feet drawdown.

Date of test 6/20/52

If Flowing Well: Measured discharge _____ g.p.m. on _____
(Date)

Shut-in pressure at ground surface _____ lbs. per sq. in. on _____
(Date)

Water is controlled by _____
(Cap, valve, etc.)

8. Casing: (Give diameter, commercial specifications and depth below ground surface of each casing size.)

..... inch diameter from to feet

..... inch diameter from to feet

..... inch diameter from to feet

..... inch diameter from to feet

Describe and show depth of shoe, plug, adapter, liner or other details:

.....

9. Perforated Casings or Screens:

..... from to
(Number per foot and size of perforations, or describe screen)

..... from to

..... from to

..... from to

10. Log of Well: (Describe each stratum or formation clearly, indicate if water bearing, and give thickness and depth as indicated.)

MATERIAL	Thickness (Feet)	Depth to Bottom (Feet)
Dirt	7	7
Cement rock	7	0

If log of well is not available, give name and address of driller.

11. Infiltration Trench: Covered or open

Dimensions: Length ft. Minimum depth ft. Maximum depth ft.

Bottom width ft. Discharge g.p.m. Date of test

12. Tunnel: Type of lining

Dimensions:
(Length, course, and cross sectional size)

Position of water bearing stratum with reference to portal of tunnel

Log of tunnel: (Preceding table for log of well may be used, if desired. Give footage from portal and character of materials, as pertinent.)

13. Pumping Equipment:

(a) Pump Berkley 3 phase 75 H.P. Capacity 500 g.p.m.
(above is one unit) (Make, type and size)


(b) Motor
(Type and horsepower)

14. Location of area irrigated or to be irrigated, or place of use if for purposes other than irrigation.

Township North or South	Range E. or W. of Willamette Meridian	Section	Forty-acre Tract	Number Acres To Be Irrigated	Date of Reclamation
18 S	2 W	22	South & north of section line	86 Total	
			Our pond is located so we can irrigate all the ground shown; however we have never irrigated all the area shown any one year we usually irrigate about 40 acres, depending on the crop, but not necessarily the same 40 each year.		
T18S	R2W	22	NE $\frac{1}{4}$ of SW $\frac{1}{4}$	40	1952
"	"	"	SE $\frac{1}{4}$ of NW $\frac{1}{4}$	7	"
"	"	"	SW $\frac{1}{4}$ of NE $\frac{1}{4}$	4	"
"	"	"	NW $\frac{1}{4}$ of SE $\frac{1}{4}$	5	"
"	"	"	SW $\frac{1}{4}$ of SE $\frac{1}{4}$	5	"
"	"	"	SE $\frac{1}{4}$ of SW $\frac{1}{4}$	20	"
"	"	27	NE $\frac{1}{4}$ of NW $\frac{1}{4}$	4	"
"	"	27	NW $\frac{1}{4}$ of NE $\frac{1}{4}$	1	"
				86 ac	"

15. If the ground water supply is supplemental to an existing water supply, identification of any application for a permit, permit, certificate or adjudicated right to appropriate water made or held by the registrant.

Township 1 S Range 2 W, W.M.
Section 22 North

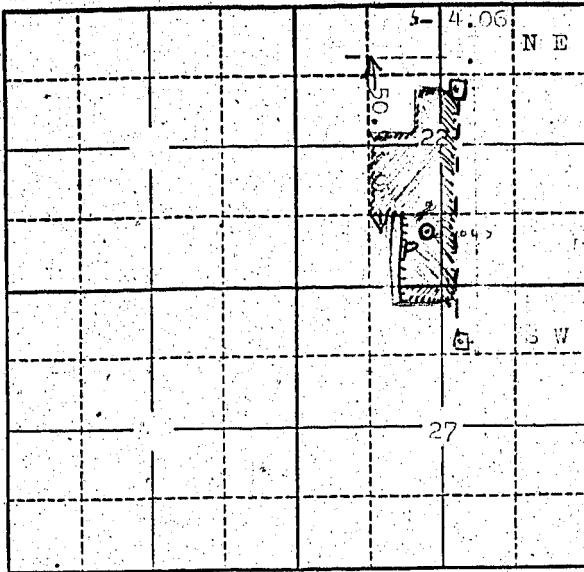

Locate well and acreage of irrigated land on plat.
Scale: 2" = 1 Mile

STATE OF OREGON

County of Lane } ss.

I, Frank Shelley, being first duly sworn, do hereby certify that I have read the foregoing Registration Statement and that all of the items therein contained are true to the best of my knowledge and belief.

Frank Shelley
(Signature of Registrant)

Subscribed and sworn to before me this 15 day of Dec, 1958

My commission expires 7-28-60
(Notary Public)

(SEAL)

CERTIFICATE OF REGISTRATION

STATE OF OREGON

County of Marion } ss.

This is to certify that the foregoing Registration Statement was received in the office of the State Engineer on the 22 day of July, 1958, at 8:00 o'clock A. M. and has been duly recorded in said office in Book No. 10 of Registration Statements on page GR-2332

Witness my hand this 10th day of March, 1959

Lewis A. Ottaway
(State Engineer)

By _____ (Deputy)

GR 2332

23-10