

RECEIVED
JUL 22 1958
STATE ENGINEER
SALEM, OREGON

Registration No. GR - 2464
Certificate No. GR 2334

Registration Statement

OF CLAIMANT OF RIGHT TO APPROPRIATE GROUND WATER

TO THE STATE ENGINEER OF OREGON:

I, Roy and Wilbur Fitzwater
of Rt. 2, Box 181, Lebanon County of Linn
(Mailing address)
State of Oregon, do hereby make application for a certificate of registration as evidence of a right to appropriate ground water.

1. Source from which water is withdrawn is pump well
(Flowing well, pump well, infiltration trench, or tunnel)
2. Location is: 4 miles N. of Lebanon, Oregon
(Approximate distance and direction from nearest city or town)

and is more particularly described as follows:

(a) N. 29° 10' W. 13 chains from NE cor. of DLG 57
(Give distance and bearing to corner of section or other legal subdivision)
being within NE¹ of NE¹ of Sec. 26, Twp. 11 S., Rge. 2 W.
(Smallest legal subdivision) (N. or S.) (E. or W.)
or (b) within limits of recorded platted property, town or city:
in Lot _____, Block _____ of _____
(Name of plat or addition)
County of Linn
(If within city or town, give name)

3. Construction Work was begun on 1942; was completed on 1942
(Date) (Date)
and the ground water claimed was first used for the purposes set out below on 1942
(Date)
since which time the water has been used continuously
(Continuously or Intermittently)
from 1942 to present time
(Date) (Date)

4. Quantity of water claimed and used is 400 gallons per minute; 328.8 acre feet per year.

5. Purpose or Purposes for which water is used Irrigation
(Domestic, irrigation, municipal, manufacturing, industrial, etc.)

6. Description of Well: Depth 57 feet. Type Drilled
(Dug or drilled)
diameter 8 inches. Elevation of ground at well site 305 feet, mean sea level.
(As near as known)
Depth to water table 11 feet.

7. Capacity of Well: _____ g.p.m. with _____ feet drawdown.
_____ g.p.m. with _____ feet drawdown.

Date of test Not Tested
If Flowing Well: Measured discharge _____ g.p.m. on _____
(Date)
Shut-in pressure at ground surface _____ lbs. per sq. in. on _____
(Date)
Water is controlled by _____
(Cap, valve, etc.)

If log of well is not available, give name and address of driller. Marion West, 1120 Market St.,

Salem, Oregon

11. Infiltration Trench: Covered or open _____
 Dimensions: Length _____ ft. Minimum depth _____ ft. Maximum depth _____ ft.
 Bottom width _____ ft. Discharge _____ g.p.m. Date of test _____

12. Tunnel: Type of lining _____
 Dimensions: _____
(Length, course, and cross sectional size)
 Position of water bearing stratum with reference to portal of tunnel _____

Log of tunnel: (Preceding table for log of well may be used, if desired. Give footage from portal and character of materials, as pertinent.)


13. Pumping Equipment:
 (a) Pump Gardner Denver 2 1/2" centrifugal Capacity 100 g.p.m.
(Make, type and size)
 (b) Motor 20 H. P. electric
(Type and horsepower)

14. Location of area irrigated or to be irrigated, or place of use if for purposes other than irrigation.

Township North or South	Range E. or W. of Willamette Meridian	Section	Forty-acre Tract	Number Acres To Be Irrigated	Date of Reclamation
11 S	2 W	23	SW 1/4 of SE 1/4	4.0	1942
11 S	2 W	23	SE 1/4 of SE 1/4	8.5	"
11 S	2 W	26	NE 1/4 of NE 1/4	10.7	"
11 S	2 W	26	NW 1/4 of NE 1/4	5.1	"
11 S	2 W	23	SE 1/4 of SE 1/4	8.5	"
11 S	2 W	24	SW 1/4 of SW 1/4	8.5	"
11 S	2 W	26	NW 1/4 of NE 1/4	4.0	"
11 S	2 W	26	NE 1/4 of NE 1/4	29.3	"
11 S	2 W	26	SW 1/4 of NE 1/4	1.0	"
11 S	2 W	26	SE 1/4 of NE 1/4	10.0	"
11 S	2 W	25	NW 1/4 of NW 1/4	15.0	"
11 S	2 W	25	SW 1/4 of NW 1/4	5.0	"
				109.6	

15. If the ground water supply is supplemental to an existing water supply, identification of any application for a permit, permit, certificate or adjudicated right to appropriate water made or held by the registrant.

Township 11 S Range 2 W W.M.
North

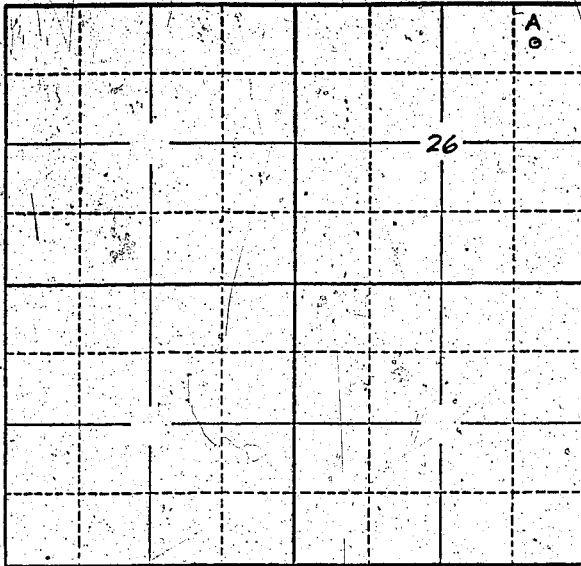

Locate well and acreage of irrigated land on plat.
Scale: 2" = 1 Mile

STATE OF OREGON

County of LINN

} ss.

I, Roy and Wilbur Fitzwater being first duly sworn, do hereby certify that I have read the foregoing Registration Statement and that all of the items therein contained are true to the best of my knowledge and belief.

Roy Fitzwater
Wilbur Fitzwater
(Signature of Registrant)

Subscribed and sworn to before me this 21st day of July 1958

My commission expires 9/18/61

Kenneth H. DeLore
(Notary Public)

(SEAL)

CERTIFICATE OF REGISTRATION

STATE OF OREGON

County of Marion

} ss.

This is to certify that the foregoing Registration Statement was received in the office of the State Engineer on the 22nd day of July, 1958, at 8:00 o'clock A.M. and has been duly recorded in said office in Book No. 10 of Registration Statements on page GR-2334

Witness my hand this 10th day of March 1959

Lewis A. Stanley
(State Engineer)

By _____ (Deputy)

\$26.00

GR - 2334