RECEIVED
JUL 22 1953
STATE ENGINEER
SALEM, OREGON

RECEIVED
JAN 28 1960
STATE ENGINEER
SALEM, OREGON

Registration No. GR - 2467

Certificate No. GR 3930

Registration Statement

OF CLAIMANT OF RIGHT TO APPROPRIATE GROUND WATER

TO THE STATE ENGINEER OF OREGON:

I, Ebert B. Andrews

of Rte. 2 Box 159 Eugene, Ore. (Mailing address) County of Lane

State of Oregon, do hereby make application for a certificate of registration as evidence of a right to appropriate ground water.

1. **Source** from which water is withdrawn is Pump well (Flowing well, pump well, infiltration trench, or tunnel)

2. **Location** is: 3 miles due North of Springfield (Approximate distance and direction from nearest city or town); fronts on Gilly River Lane and Deadmond Ferry RD. and is more particularly described as follows:

(a) located in the center of my 16 2/3 acre farm. (Give distance and bearing to corner of section or other legal subdivision)

being within Willamette Meridian (Smallest legal subdivision) of Sec. 29, Twp. 17 S (N. or S.), Rge. R3W (E. or W.)

or (b) within limits of recorded platted property, town or city:

in Lot ....., Block ..... of William Stevens Donation Land Claim #46 (Name of plat or addition)

..... (If within city or town, give name) County of Lane.

3. **Construction Work** was begun on about April 25, 1953 (Date); was completed on SAME (Date)

and the ground water claimed was first used for the purposes set out below on about May 1 1953 (Date)

since which time the water has been used continuously as required (Continuously or intermittently)

from 1953 (Date) to 1958 (Date)

4. **Quantity** of water claimed and used is 150 gallons per minute; ..... acre feet per year.

5. **Purpose or Purposes** for which water is used irrigation

..... (Domestic, irrigation, municipal, manufacturing, industrial, etc.)

6. **Description of Well:** Depth 21 feet. Type Driven (Dug or drilled)

diameter 4 inches. Elevation of ground at well site 420 (As near as known) feet, mean sea level.

Depth to water table 12 feet.

7. **Capacity of Well:** ..... g.p.m. with ..... feet drawdown.

Can not measure drawdown in a driven well

..... g.p.m. with ..... feet drawdown.

Date of test at the time well was driven

If Flowing Well: Measured discharge ..... g.p.m. on ..... (Date)

Shut-in pressure at ground surface ..... lbs. per sq. in. on ..... (Date)

Water is controlled by ..... (Cap, valve, etc.)

8. **Casing:** (Give diameter, commercial specifications and depth below ground surface of each casing size.)

..... inch diameter ..... from ..... to ..... feet

..... inch diameter ..... from ..... to ..... feet

..... inch diameter ..... from ..... to ..... feet

..... inch diameter ..... from ..... to ..... feet

Describe and show depth of shoe, plug, adapter, liner or other details: .....

9. **Perforated Casings or Screens:**

..... from ..... to .....
(Number per foot and size of perforations, or describe screen)

..... from ..... to .....

..... from ..... to .....

..... from ..... to .....

10. **Log of Well:** (Describe each stratum or formation clearly, indicate if water bearing, and give thickness and depth as indicated.)

MATERIAL	Thickness (Feet)	Depth to Bottom (Feet)
River bottom land		
Hit gravel at about 14'		
Hit solid rock at 21'		

GR 3930

If log of well is not available, give name and address of driller. Drove well myself

11. **Infiltration Trench:** Covered or open .....

Dimensions: Length ..... ft. Minimum depth ..... ft. Maximum depth ..... ft.

Bottom width ..... ft. Discharge ..... g.p.m. Date of test .....

12. **Tunnel:** Type of lining .....

Dimensions: ..... (Length, course, and cross sectional size)

Position of water bearing stratum with reference to portal of tunnel .....

Log of tunnel: (Preceding table for log of well may be used, if desired. Give footage from portal and character of materials, as pertinent.)

13. **Pumping Equipment:**

(a) Pump Fairbanks-Morse 7½ H.P. (Make, type and size) Capacity 200 g.p.m.

(b) Motor 7½ H.P. Centrifugal (Type and horsepower)

14. Location of area irrigated or to be irrigated, or place of use if for purposes other than irrigation.

Township North or South	Range E. or W. of Willamette Meridian	Section	Forty-acre Tract	Number Acres To Be Irrigated	Date of Reclamation
T17S	R3W	23	NW¼ of NW¼	8.0 Ac	1953
"	"	23	NE¼ of NW¼	8.0 Ac	"
"	"	15	SE¼ of SW¼	0.66 Ac	"
				16.66 Ac	"

15. If the ground water supply is supplemental to an existing water supply, identification of any application for a permit, permit, certificate or adjudicated right to appropriate water made or held by the registrant.

.....

GR 3930

Township 17 S Range R 3 W, W.M.

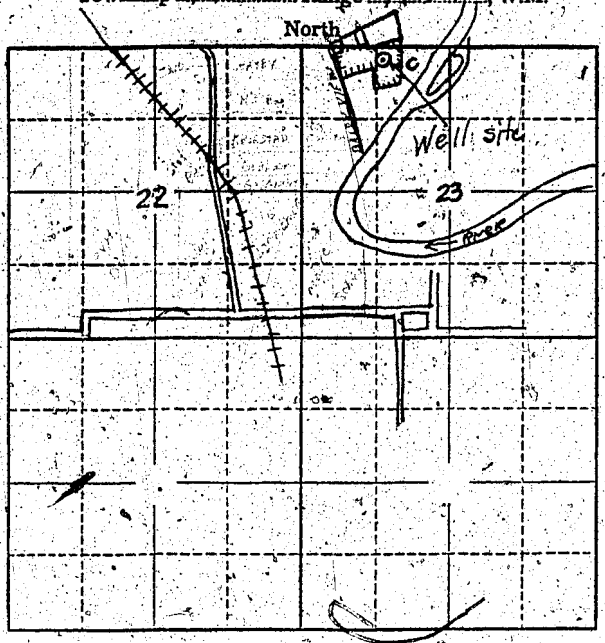

Locate well and acreage of irrigated land on plat.

Scale: 2" — 1 Mile

STATE OF OREGON
County of Lane } ss.

I, Obert B Andrews, being first duly sworn, do hereby certify that I have read the foregoing Registration Statement and that all of the items therein contained are true to the best of my knowledge and belief.

Obert B Andrews
(Signature of Registrant)

Subscribed and sworn to before me this 21st day of July, 1955.

My commission expires Sept 5 1959

E Kraus
(Notary Public)

(SEAL)

CERTIFICATE OF REGISTRATION

STATE OF OREGON
County of Marion } ss.

This is to certify that the foregoing Registration Statement was received in the office of the State Engineer on the 22nd day of July, 1958, at 8:00 o'clock A M. and has been duly recorded in said office in Book No. 16 of Registration Statements on page GR-3930

Witness my hand this 15th day of February, 1960

Lewis A. Stanley
(State Engineer)

$15.00

By _____
(Deputy)

GR 3930