

RECEIVED

MAY 23 1957

STATE ENGINEER
SALEM, OREGON

REGISTRATION NO. GR-2468

CERTIFICATE NO. GR-2337

Registration Statement

OF CLAIMANT OF RIGHT TO APPROPRIATE GROUND WATER

(Under Chapter 708, Oregon Laws 1955.)

TO THE STATE ENGINEER OF OREGON:

I, Raymond M. Schneider
of _____ County of Clackamas

State of Oregon, do hereby make application for a certificate of registration as evidence of a right to appropriate ground water.

- 1. Source from which water is withdrawn is pump well
(Flowing well, pump well, infiltration trench, or tunnel)
- 2. Location is: 3 miles north of Morriston
(Approximate distance and direction from nearest city or town)

and is more particularly described as follows:

(a) Beginning 1000 feet west & 200 feet north from S.E. corner Section 13
(Give distance and bearing to corner of section or other legal subdivision)
being within Wm. Elliott's wife L.C. 45
(Smallest legal subdivision) of Sec. 13; Twp. 5 South, Rge. 1 W
(N. or S.) (E. or W.)

for (b) within limits of recorded platted property, town or city:
in Lot _____, Block _____ of _____
(Name of plat or addition)

County of _____
(If within city or town, give name)

3. Construction Work was begun on 1942; was completed on June 1951
(Date) (Date)

and the ground water claimed was first used for the purposes set out below on June 1951
(Date)

since which time the water has been used continuously
(Continuously or intermittently)

from 1951 to 1957
(Date) (Date)

4. Quantity of water claimed and used is 65 gal gallons per minute; _____ acre feet per year.

5. Purpose or Purposes for which water is used irrigation
(Domestic, irrigation, municipal, manufacturing, industrial, etc.)

6. Description of Well: Depth 155 feet. Type drilled
(Dug or drilled)

diameter 6 inches. Elevation of ground at well site 100 (?) feet, mean sea level.
(As near as known)

Depth to water table 24 feet.

7. Capacity of Well: 2500 g.p.m. with 50 feet drawdown.

_____ g.p.m. with _____ feet drawdown.

Date of test 1951 - June

If Flowing Well: Measured discharge _____ g.p.m. on _____
(Date)

Shut-in pressure at ground surface _____ lbs. per sq. in. on _____
(Date)

Water is controlled by _____
(Cap, valve, etc.)


8. Casing: (Give diameter, commercial specifications and depth below ground surface of each casing size.)

6 inch diameter *steel* from *surface* to *112* feet
 inch diameter from to feet
 inch diameter from to feet
 inch diameter from to feet

Describe and show depth of shoe, plug, adapter, liner or other details:

9. Perforated Casings or Screens:

(Number per foot and size of perforations, or describe screen)

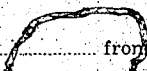

from to
 from to
 from to
 from to

10. Log of Well: (Describe each stratum or formation clearly, indicate if water bearing, and give thickness and depth as indicated.)

MATERIAL	Thickness (Feet)	Depth to Bottom (Feet)
at 76 to 114 ft - gravel stratum clay	18	59
126 to 129 ft - gravel clay	3	21
150 to 155 ft gravel	5	—

If log of well is not available, give name and address of driller: Byron Ballweber
Mr. Weatherman, Rt. 2, Oregon

11. Infiltration Trench: Covered or open

Dimensions: Length ft. Minimum depth ft. Maximum depth ft.

Bottom width ft. Discharge g.p.m. Date of test

12. Tunnel: Type of lining

Dimensions:
(Length, course, and cross sectional size)

Position of water bearing stratum with reference to portal of tunnel

Log of tunnel: (Preceding table for log of well may be used, if desired. Give footage from portal and character of materials, as pertinent.)

13. Pumping Equipment:

(a) Pump Cook Turbette Capacity 6.5 g.p.m.
(Make, type and size)

(b) Motor 3 h.p. Geo
(Type and horsepower)


14. Location of area irrigated or to be irrigated, or place of use if for purposes other than irrigation.

Township North or South	Range E. or W. of Willamette Meridian	Section	Forty-acre Tract	Number Acres To Be Irrigated	Date of Reclamation
<u>5-S</u>	<u>1W</u>	<u>13</u>	<u>SW 1/4 of SE 1/4</u>	<u>8.5</u>	<u>approx. 1951</u>
<u>5S</u>	<u>1W</u>	<u>13</u>	<u>SE 1/4 of SE 1/4</u>	<u>14.5</u>	<u>"</u>
				<u>22.0 Ac</u>	

15. If the ground water supply is supplemental to an existing water supply, identification of any application for a permit, permit, certificate or adjudicated right to appropriate water made or held by the registrant.

only 1 well

Township 5 S Range 1 W W.M.
North

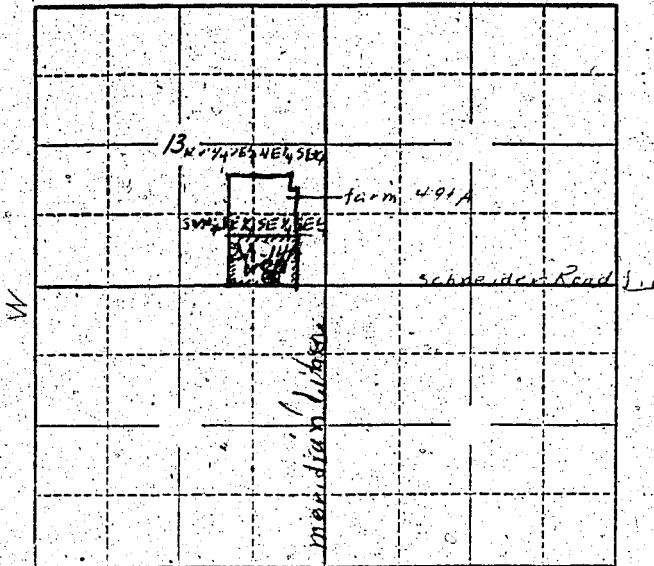

Locate well and acreage of irrigated land on plat.
Scale: 2" = 1 Mile

STATE OF OREGON

County of Tackamas } ss.

I, Raymond M. Schneider, being first duly sworn, do hereby certify that I have read the foregoing Registration Statement and that all of the items therein contained are true to the best of my knowledge and belief.

Raymond M. Schneider
(Signature of Registrant)

Subscribed and sworn to before me this 20 day of July 1957.

My commission expires July 22 - 1957

Erwin J. [Signature]
(Notary Public)

(SEAL)

CERTIFICATE OF REGISTRATION

STATE OF OREGON

County of Marion } ss.

This is to certify that the foregoing Registration Statement was received in the office of the State Engineer on the 22 day of July, 1958, at 8:00 o'clock A. M. and has been duly recorded in said office in Book No. 10 of Registration Statements on page GR-2337

Witness my hand this 10th day of March, 1959

Lewis A. Ottensley
(State Engineer)

\$15.00

By _____ (Deputy)

GR-2337