

Registration Statement

OF CLAIMANT OF RIGHT TO APPROPRIATE GROUND WATER

TO THE STATE ENGINEER OF OREGON:

I, Stephen G. Nye

of R. 3, Box 205, Medford County of Jackson

State of Oregon hereby make application for a certificate of registration as evidence of a right to appropriate ground water.

1. Source from which water is withdrawn is well and 2000 feet of tiling
(Flowing well, pump well, infiltration trench, or tunnel)

2. Location is: 1 mile Northwest of Talent, Oregon
(Approximately distance and direction from nearest city or town)

and is more particularly described as follows:

(a) 1470 feet North and 94 feet East from the SW Cor. DLG 52
(Give distance and bearing to corner of section or other legal subdivision)

being within SW 1/4 NW 1/4 of Sec. 25, Twp. 38S, Rge. 1 W
(Smallest legal subdivision) (N. or S.) (E. or W.)

or (b) within limits of recorded platted property, town or city:

in Lot _____, Block _____ of _____
(Name of plat or addition)

County of _____
(If within city or town, give name)

3. Construction Work was begun on 1940; was completed on 1940
(Date) (Date)

and the ground water claimed was first used for the purposes set out below on 1940
(Date)

since which time the water has been used Intermittently
(Continuously or Intermittently)

from 1940 to present
(Date) (Date)

4. Quantity of water claimed and used is 100 gallons per minute; 60 acre feet per year.

5. Purpose or Purposes for which water is used Supplemental Irrigation and Industrial use (Orchard spraying)
(Domestic, irrigation, municipal, manufacturing, industrial, etc.)

6. Description of Well: Depth 6.0 feet. Type Dug
(Dug or drilled)

diameter 24 inches. Elevation of ground at well site 1600 feet, mean sea level
(As near as known)

Depth to water table 2.0 feet.

7. Capacity of Well: _____ g.p.m. with _____ feet drawdown.

_____ g.p.m. with _____ feet drawdown.

Date of test none

If Flowing Well: Measured discharge _____ g.p.m. on _____
(Date)

Shut-in pressure at ground surface _____ lbs. per sq. in. on _____
(Date)

Water is controlled by _____
(Cap, valve, etc.)

8. Casing: (Give diameter, commercial specifications and depth below ground surface of each casing size.)

24 inch diameter concrete tile from 0 to 6 feet
inch diameter from to feet
inch diameter from to feet
3/4 inch diameter from to feet

Describe and show depth of shoe, plug, adapter, liner or other details:

9. Perforated Casings or Screens:-

none from to
(Number per foot and size of perforations, or describe screen)
from to
from to
from to

10. Log of Well: (Describe each stratum or formation clearly, indicate if water bearing, and give thickness and depth as indicated.)

MATERIAL	Thickness (Feet)	Depth to Bottom (Feet)
not known		

If log of well is not available, give name and address of driller: Fred Schaffel--- address not known

11. Infiltration Trench: Covered or open

Dimensions: Length ft. Minimum depth ft. Maximum depth ft.
Bottom width ft. Discharge g.p.m. Date of test

12. Tunnel: Type of lining

Dimensions:
(Length, course, and cross sectional size)

Position of water bearing stratum with reference to portal of tunnel

Log of tunnel: (Preceding table for log of well may be used, if desired. Give footage from portal and character of materials, as pertinent.)

13. Pumping Equipment:

(a) Pump 2.0 inch Centrifugal pump Capacity g.p.m.
(Make, type and size)

(b) Motor 4.5 H.P. Gasoline engine
(Type and horsepower)


14. Location of area irrigated or to be irrigated, or place of use if for purposes other than irrigation.

Township North or South	Range E. or W. of Willamette Meridian	Section	Forty-acre Tract	Number Acres To Be Irrigated	Date of Reclamation
38 S	1 W	25	SW ¹ ₄ NW ¹ ₄	6.0 acres (Suppl.)	1940
"	"	22	NW ¹ ₄ NE ¹ ₄	Industrial use	1940
"	"	22	SW ¹ ₄ NE ¹ ₄	" " "	"
"	"	22	SE ¹ ₄ NE ¹ ₄	" " "	"
"	"	22	NE ¹ ₄ NE ¹ ₄ SE ¹ ₄	" " "	"
"	"	25	SW ¹ ₄ NW ¹ ₄	" " "	"
"	"	25	NE ¹ ₄ NW ¹ ₄ SW ¹ ₄	" " "	"
"	"	25	NW ¹ ₄ NE ¹ ₄ SW ¹ ₄	" " "	"

15. If the ground water supply is supplemental to an existing water supply, identification of any application for a permit, permit, certificate or adjudicated right to appropriate water made or held by the registrant.
Supplemental to the Talent Irrigation District rights

Township 38 S. Range 1 W., W.M.

North

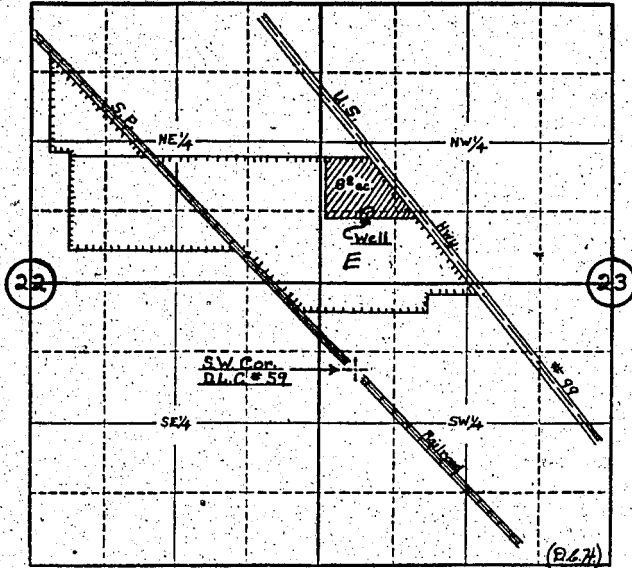

Locate well and acreage of irrigated land on plat.

Scale: 4" = 1 Mile

STATE OF OREGON

County of Jackson } ss.

I, Stephen G. Nye, being first duly sworn, do hereby certify that I have read the foregoing Registration Statement and that all of the items therein contained are true to the best of my knowledge and belief.

Stephen G. Nye
(Signature of Registrant)

Subscribed and sworn to before me this 21st day of July, 1958.

My commission expires Oct. 23-1960

Lloyd A. Lewis
(Notary Public)

(SEAL)

CERTIFICATE OF REGISTRATION

STATE OF OREGON } ss.

County of Marion

This is to certify that the foregoing Registration Statement was received in the office of the State Engineer on the 22 day of July, 1958, at 8:00 o'clock A. M. and has been duly recorded in said office in Book No. 10 of Registration Statements on page GR-2343

Witness my hand this 10th day of March, 1959

Lewis A. Standley
(State Engineer)

25.00

By _____
(Deputy)

GR 2343