

Registration No. GR-2475  
Certificate No. GR 2344

# Registration Statement

## OF CLAIMANT OF RIGHT TO APPROPRIATE GROUND WATER

TO THE STATE ENGINEER OF OREGON:

I, CHARLES E. SMITH

of 7015 River Road, Junction City, County of Lane

State of Oregon, do hereby make application for a certificate of registration as evidence of a right to appropriate ground water.

- Source from which water is withdrawn is Pump Well  
(Flowing well, pump well, infiltration trench, or tunnel)
- Location is: 7 miles southeast of Junction City, Oregon  
(Approximate distance and direction from nearest city or town)

and is more particularly described as follows:

(a) 0.64 chs. North and 12.65 chs. East of West 1/2 corner Section 35, T16S R4W  
(Give distance and bearing to corner of section or other legal subdivision)  
being within S.W. 1/4, N.W. 1/4 of Sec. 35, Twp. 16 South, Rge. 4 West  
(Smallest legal subdivision) (N. or S.) (E. or W.)

or (b) within limits of recorded platted property, town or city:

in Lot \_\_\_\_\_, Block \_\_\_\_\_ of \_\_\_\_\_  
(Name of plat or addition)  
County of \_\_\_\_\_  
(If within city or town, give name)

3. Construction Work was begun on 1944; was completed on 1944  
(Date) (Date)  
and the ground water claimed was first used for the purposes set out below on 1944  
(Date)

since which time the water has been used continuously  
(Continuously or intermittently)  
from 1944 to 1958  
(Date) (Date)

4. Quantity of water claimed and used is 48 gallons per minute; 14 acre feet per year.

5. Purpose or Purposes for which water is used irrigation  
(Domestic, irrigation, municipal, manufacturing, industrial, etc.)

6. Description of Well: Depth 20 feet. Type Driven  
(Dug or drilled)  
diameter 2 - 2" inches. Elevation of ground at well site 375 feet, mean sea level.  
(As near as known)  
Depth to water table 15 feet.

7. Capacity of Well: 60 g.p.m. with 3 feet drawdown.  
         g.p.m. with          feet drawdown.

Date of test none

If Flowing Well: Measured discharge          g.p.m. on           
(Date)

Shut-in pressure at ground surface          lbs. per sq. in. on           
(Date)

Water is controlled by           
(Cap. valve, etc.)

8. Casing: (Give diameter, commercial specifications and depth below ground surface of each casing size.)

2 - 2" inch diameter ..... from 0 ..... to 20 ..... feet  
 ..... inch diameter ..... from ..... to ..... feet  
 ..... inch diameter ..... from ..... to ..... feet  
 ..... inch diameter ..... from ..... to ..... feet

Describe and show depth of shoe, plug, adapter, liner or other details: .....  
 .....  
 .....

9. Perforated Casings or Screens:

Slotted or perforated bottom 4' ..... from ..... to .....  
(Number per foot and size of perforations, or describe screen)  
 ..... from ..... to .....  
 ..... from ..... to .....  
 ..... from ..... to .....

10. Log of Well: (Describe each stratum or formation clearly, indicate if water bearing, and give thickness and depth as indicated.)

MATERIAL	Thickness (Feet)	Depth to Bottom (Feet)
12' Soil and loam	12	12
8' Gravel and sand	8	20
Now using 17 - 6 to 8 Rainbird sprinklers		
360' x 3" main line pipe		
360' x 1½" lateral pipe		

If log of well is not available, give name and address of driller. .... unknown .....

11. Infiltration Trench: Covered or open .....

Dimensions: Length ..... ft. Minimum depth ..... ft. Maximum depth ..... ft.

Bottom width ..... ft. Discharge ..... g.p.m. Date of test .....

12. Tunnel: Type of lining .....

Dimensions: ..... (Length, course, and cross sectional size)

Position of water bearing stratum with reference to portal of tunnel .....

Log of tunnel: (Preceding table for log of well may be used, if desired. Give footage from portal and character of materials, as pertinent.)

13. Pumping Equipment:

(a) Pump Fairbanks-Morse Cent. 3" x 2" Capacity ..... g.p.m.  
(Make, type and size)


(b) Motor Ford tractor ..... (Type and horsepower)

14. Location of area irrigated or to be irrigated, or place of use if for purposes other than irrigation.

Township North or South	Range E. or W. of Willamette Meridian	Section	Forty-acre Tract	Number Acres To Be Irrigated	Date of Reclamation
16 South	4 West	35	S.W. 1/4, N.W. 1/4	5.3	1944
16 South	4 West	35	S.E. 1/4, N.W. 1/4	0.6	"
16 South	4 West	35	N.W. 1/4, S.W. 1/4	1.9	"
16 South	4 West	35	N.E. 1/4, S.W. 1/4	1.2	"
				<u>9.0</u>	

15. If the ground water supply is supplemental to an existing water supply, identification of any application for a permit, certificate or adjudicated right to appropriate water made or held by the registrant.

Township 16.5 Range 4W, W.M.  
North

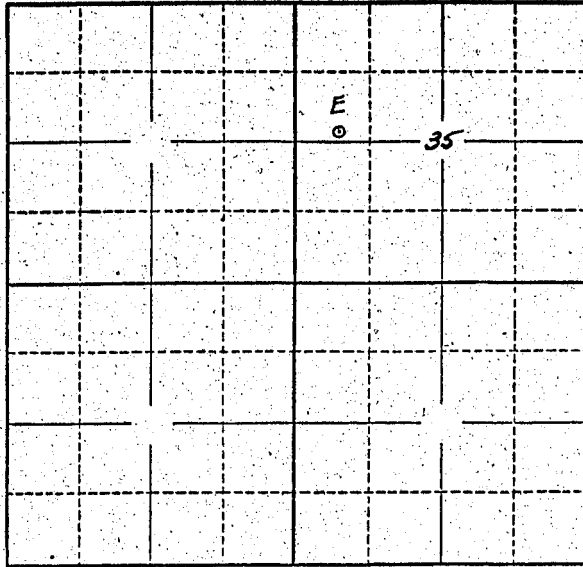

Locate well and acreage of irrigated land on plat.  
Scale: 2" = 1 Mile

STATE OF OREGON

County of Linn } ss.

I, Charles E. Smith, being first duly sworn, do hereby certify that I have read the foregoing Registration Statement and that all of the items therein contained are true to the best of my knowledge and belief.

Charles E. Smith  
(Signature of Registrant)

Subscribed and sworn to before me this 19th day of July, 19 58

My commission expires 2-5-61

Francis E. [Signature]  
(Notary Public)

(SEAL)

**CERTIFICATE OF REGISTRATION**

STATE OF OREGON

County of Marion } ss.

This is to certify that the foregoing Registration Statement was received in the office of the State Engineer on the 22nd day of July, 1958, at 8.00 o'clock A. M. and has been duly recorded in said office in Book No. 10 of Registration Statements on page GR-2344

Witness my hand this 10th day of March, 19 59

Lewis A. Stanley  
(State Engineer)

By \_\_\_\_\_ (Deputy)

\$ 15.00