

# Registration Statement

## OF CLAIMANT OF RIGHT TO APPROPRIATE GROUND WATER

TO THE STATE ENGINEER OF OREGON:

I, Jim Slighter  
 of 5410 Auburn Rd. Salem County of Marene  
(Mailing address)  
 State of Oregon do hereby make application for a certificate of registration as evidence of a right to appropriate ground water.

1. Source from which water is withdrawn is pumped from well  
(Flowing well, pump well, infiltration trench, or tunnel)
2. Location is: east of Salem 4 miles  
(Approximate distance and direction from nearest city or town)

and is more particularly described as follows:

(a) 3200' N & 2200' W from SE corner Section 29  
(Give distance and bearing to corner of section or other legal subdivision)  
 being within SW<sup>1</sup>/<sub>4</sub> NE<sup>1</sup>/<sub>4</sub> of Sec. 29, Twp. 7S, Rge. 2W  
(Smallest legal subdivision) (N. or S.) (E. or W.)

or (b) within limits of recorded platted property, town or city:  
 in Lot \_\_\_\_\_, Block \_\_\_\_\_ of \_\_\_\_\_  
(Name of plat or addition)  
 County of \_\_\_\_\_  
(If within city or town, give name)

3. Construction Work was begun on June 15 1949 was completed on June 21 1949  
(Date) (Date)  
 and the ground water claimed was first used for the purposes set out below on July 16 1949  
(Date)  
 since which time the water has been used during irrigation seasons each season  
(Continuous or intermittently)  
 from \_\_\_\_\_ to \_\_\_\_\_  
(Date) (Date)

4. Quantity of water claimed and used is 80 gallons per minute; 7 1/2 acre feet per year.

5. Purpose or Purposes for which water is used irrigation, orchard, pasture and for some domestic purposes  
(Domestic, irrigation, municipal, manufacturing, industrial, etc.)

6. Description of Well: Depth 60 feet. Type 2" drilled  
(Dug or drilled)  
 diameter 6 inches. Elevation of ground at well site \_\_\_\_\_ feet, mean sea level.  
(As near as known)  
 Depth to water table 5 feet feet.

7. Capacity of Well: 80 g.p.m. with 20 feet drawdown.  
 \_\_\_\_\_ g.p.m. with \_\_\_\_\_ feet drawdown.

Date of test June 15 1949

If Flowing Well: Measured discharge \_\_\_\_\_ g.p.m. on \_\_\_\_\_ (Date)

Shut-in pressure at ground surface \_\_\_\_\_ lbs. per sq. in. on \_\_\_\_\_ (Date)


Water is controlled by \_\_\_\_\_ (Cap, valve, etc.)





State Eng  
170 Dec 12

Township 75 Range 2W W.M.  
North

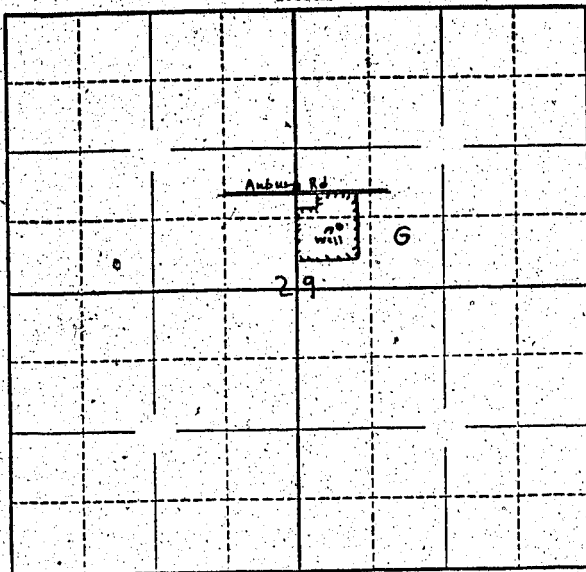

Locate well and acreage of irrigated land on plat.  
Scale:  $\frac{1}{4}$  - 1 Mile

STATE OF OREGON

County of Marion } ss.

I, J. M. Sleight, being first duly sworn, do hereby certify that I have read the foregoing Registration Statement and that all of the items therein contained are true to the best of my knowledge and belief.

J. M. Sleight  
(Signature of Registrant)

Subscribed and sworn to before me this \_\_\_\_\_ day of \_\_\_\_\_, 19\_\_\_\_.

My commission expires 9-9-54

W. C. [unclear]  
(Notary Public)

(SEAL)

**CERTIFICATE OF REGISTRATION**

STATE OF OREGON

County of Marion } ss.

This is to certify that the foregoing Registration Statement was received in the office of the State Engineer on the 22nd day of July, 1958, at 8<sup>00</sup> o'clock A M. and has been duly recorded in said office in Book No. 10 of Registration Statements on page GR-2345

Witness my hand this 10<sup>th</sup> day of March, 1959

Lewis A. Stanley  
(State Engineer)

#1500

By \_\_\_\_\_ (Deputy)

GR - 2345