

RECEIVED
JUL 27 1958
STATE ENGINEER
SALES DIVISION

Registration No. GR 2478
Certificate No. GR 2347

Registration Statement

OF CLAIMANT OF RIGHT TO APPROPRIATE GROUND WATER

TO THE STATE ENGINEER OF OREGON:

I, Mildred Moretz
of 418 Washington St. Dayton County of Columbia
State of Washington, do hereby make application for a certificate of registration as evidence of a right to appropriate ground water.

1. Source from which water is withdrawn is Pump well
(Flowing well, pump well, infiltration trench, or tunnel)

2. Location is: 2.5 miles NW of Prineville
(Approximate distance and direction from nearest city or town)

and is more particularly described as follows: 310 ft. west & 50 ft. north from SE corner.

(a) SE corner of the East 5 acres
(Give distance and bearing to corner of section or other legal subdivision)

being within S 1/2 of N 1/2 of SE 1/4 of SE 1/4 of Sec. 28, Twp. 6N, Rge. 35 E. W.M.
(Smallest legal subdivision) (N. or S.) (E. or W.)

or (b) within limits of recorded platted property, town or city:

in Lot _____ Block _____ of _____
(Name of plat or addition)
County of _____
(If within city or town, give name)

3. Construction Work was begun on 19 18; was completed on 19 18
(Date) (Date)

and the ground water claimed was first used for the purposes set out below on 19 16
(Date)

since which time the water has been used intermittently
(Continuously or Intermittently)
from June 1 to Oct. 1
(Date) (Date)

4. Quantity of water claimed and used is 150 gallons per minute; _____ acre feet per year.

5. Purpose or Purposes for which water is used

irrigation
(Domestic, irrigation, municipal, manufacturing, industrial, etc.)

6. Description of Well: Depth _____ feet. Type _____
(Dug or drilled)

diameter _____ inches. Elevation of ground at well site _____ feet, mean sea level.
(As near as known)

Depth to water table 22 feet.

7. Capacity of Well: _____ g.p.m. with _____ feet drawdown. This well has not

_____ g.p.m. with _____ feet drawdown. been pumped at


Date of test At place T. line 7-8-58 MAXIMUM output

If Flowing Well: Measured discharge _____ g.p.m. on _____
(Date)

Shut-in pressure at ground surface _____ lbs. per sq. in. on _____
(Date)

Water is controlled by _____
(Cap. valve, etc.)

Township 6 N Range 35 E, W.M.
North

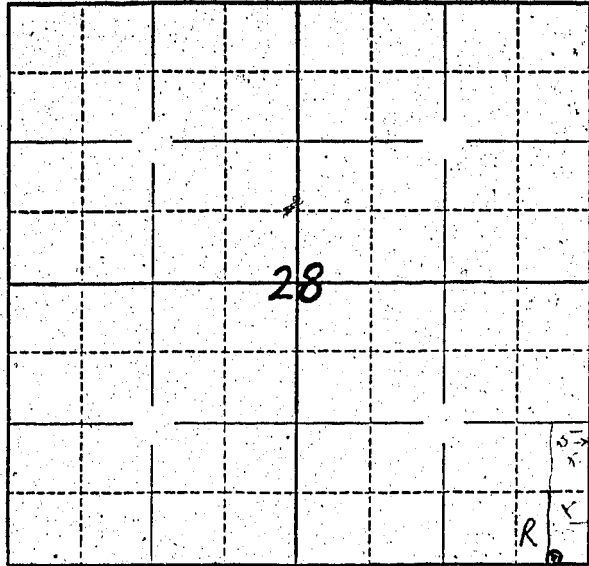

Locate well and acreage of irrigated land on plat.

Scale: - 1 Mile

STATE OF ~~OREGON~~ WASHINGTON } ss.
County of WHATCOM

I, MILDRED MORETZ, being first duly sworn, do hereby certify that I have read the foregoing Registration Statement and that all of the items therein contained are true to the best of my knowledge and belief.

Mildred Moretz
(Signature of Registrant)

Subscribed and sworn to before me this 15 day of July, 19 58

My commission expires Jan. 8, 1962

Port B. Shepard
(Notary Public)

(SEAL)

CERTIFICATE OF REGISTRATION

STATE OF OREGON } ss.
County of Marion

This is to certify that the foregoing Registration Statement was received in the office of the State Engineer on the 22nd day of July, 1958, at 1.00 o'clock P. M. and has been duly recorded in said office in Book No. 10 of Registration Statements on page GR-2347

Witness my hand this 10th day of March, 19 59

Laura A. Stanley
(State Engineer)

\$1500

By _____
(Deputy)