

# Registration Statement

REGISTRATION NO. GR-2480  
CERTIFICATE NO. GR-2348

## OF CLAIMANT OF RIGHT TO APPROPRIATE GROUND WATER

(Under Chapter 708, Oregon Laws 1955.)

### TO THE STATE ENGINEER OF OREGON:

I, William Meyer, and Annie Meyer, his wife,  
of Rt. 3, Box 187, Canby, County of Clackamas

State of Oregon, do hereby make application for a certificate of registration as evidence of a right to appropriate ground water.

1. Source from which water is withdrawn is Pump Well  
(Flowing well, pump well, infiltration trench, or tunnel)

2. Location is: 3 1/2 miles S. E. from Canby, Oregon,  
(Approximate distance and direction from nearest city or town)

and is more particularly described as follows:

(a) Approximately 110 rods S. and 35 rods E. from the N. W. Corner of the NW 1/4 Sec. 15  
(Give distance and bearing to corner of section or other legal subdivision)  
being within NW 1/4 of the SW 1/4 of NW 1/4 of Sec. 15, Twp. 1 S. Rge. 1 E.  
(Smallest legal subdivision) (N. or S.) (E. or W.)

or (b) within limits of recorded platted property, town or city:

in Lot \_\_\_\_\_, Block \_\_\_\_\_ of \_\_\_\_\_  
(Name of plat or addition)

County of \_\_\_\_\_  
(If within city or town, give name)

3. Construction Work was begun on Sept. 1951; was completed on Nov. 1951  
(Date) (Date)

and the ground water claimed was first used for the purposes set out below on June 1952  
(Date)

since which time the water has been used intermittently  
(Continuously or Intermittently)

from June 1952 to September forever  
(Date) (Date)

4. Quantity of water claimed and used is 125 gallons per minute; \_\_\_\_\_ acre feet per year.

5. Purpose or Purposes for which water is used irrigation

(Domestic, irrigation, municipal, manufacturing, industrial, etc.)

6. Description of Well: Depth 30 feet. Type dug  
(Dug or drilled)

diameter 72 inches. Elevation of ground at well site 193 feet, mean sea level.  
(As near as known)

Depth to water table 14 feet.

7. Capacity of Well: 90 g.p.m. with 5 feet drawdown.

125 g.p.m. with 20 feet drawdown.

Date of test Nov. 1951

If Flowing Well: Measured discharge \_\_\_\_\_ g.p.m. on \_\_\_\_\_  
(Date)

Shut-in pressure at ground surface \_\_\_\_\_ lbs. per sq. in. on \_\_\_\_\_  
(Date)

Water is controlled by \_\_\_\_\_  
(Cap, valve, etc.)

8. Casing: (Give diameter, commercial specifications and depth below ground surface of each casing size.)

72 inch diameter Steel Casing from top to bottom feet  
 inch diameter from to feet  
 inch diameter from to feet  
 inch diameter from to feet

Describe and show depth of shoe, plug, adapter, liner or other details:

9. Perforated Casings or Screens:


None from to  
(Number per foot and size of perforations, or describe screen)  
 from to  
 from to  
 from to

10. Log of Well: (Describe each stratum or formation clearly, indicate if water bearing, and give thickness and depth as indicated.)

MATERIAL	Thickness (Feet)	Depth to Bottom (Feet)
Amity	2 ft.	2 ft.
Willamette	3 ft.	5 ft.
Clay	8 ft.	13 ft.
Gravel	17 ft.	30 ft.



Township ..... 4 S. Range ..... 1 E. .... W.M.  
North

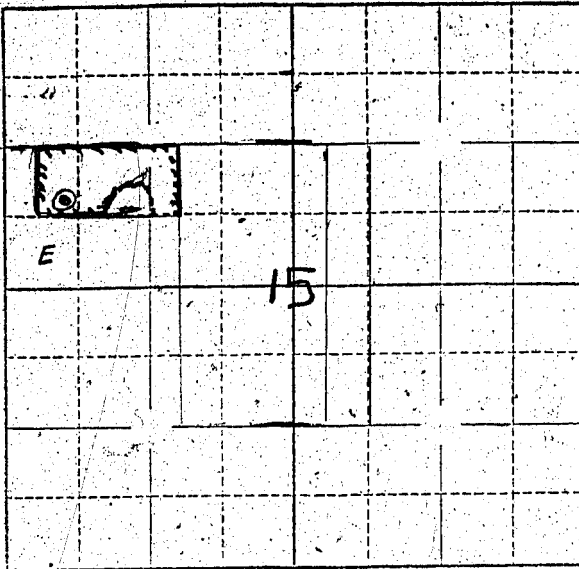

Locate well and acreage of irrigated land on plat.

Scale:  $\frac{1}{2}$  = 1 Miles

STATE OF OREGON

County of Clackamas

ss.

I, William Meyer, being first duly sworn, do hereby certify that I have read the foregoing Registration Statement and that all of the items therein contained are true to the best of my knowledge and belief.

*William Meyer*  
(Signature of Registrant)

Subscribed and sworn to before me this 21st day of July, 1958.

My commission expires Jan. 24, 1960.

(Notary Public)

(SEAL)

CERTIFICATE OF REGISTRATION

STATE OF OREGON

County of Marion

ss.

This is to certify that the foregoing Registration Statement was received in the office of the State Engineer on the 22nd day of July, 1958, at 8:00 o'clock A.M. and has been duly recorded in said office in Book No. 10 of Registration Statements on page GR-2348

~~Every person shall be completely by...~~

Witness my hand this 10th day of March, 1959.

*Leura J. Stanley*  
(State Engineer)

By

(Deputy)

GR-2348

1/500