

Registration Statement

OF CLAIMANT OF RIGHT TO APPROPRIATE GROUND WATER

TO THE STATE ENGINEER OF OREGON:

I, Eugene D. MacCarthy
of Rt 3 Box 833 Salsm County of Marian
(Mailing address)

State of Oregon do hereby make application for a certificate of registration as evidence of a right to appropriate ground water.

- 1. Source from which water is withdrawn is Pump Well
(Flowing well, pump well, infiltration trench, or tunnel)
- 2. Location is: 2 Miles East of Independence
(Approximate distance and direction from nearest city or town)

and is more particularly described as follows:

(a) 20.9 Ft S and 247.1 Ft W from East 1/4 Corner of Sect 27
(Give distance and bearing to corner of section or other legal subdivision)
being within NW 1/4 SE 1/4 of Sec. 27, Twp. 8 S, Rge. 4 W
(Smallest legal subdivision) (N. or S.) (E. or W.)

or (b) within limits of recorded platted property, town or city:
in Lot _____ Block _____ of _____
(Name of plat or addition)

County of Marian
(If within city or town, give name)

3. Construction Work was begun on June 1948; was completed on June 1948
(Date) (Date)

and the ground water claimed was first used for the purposes set out below on June 1948
(Date)

since which time the water has been used for Farm Irrigation - Intermittently
(Continuously or intermittently)

from June 1948 to Still in Use
(Date) (Date)

4. Quantity of water claimed and used is 1350 gallons per minute; _____ acre feet per year.

5. Purpose or Purposes for which water is used Farm Irrigation
(Domestic, irrigation, municipal, manufacturing, industrial, etc.)

6. Description of Well: Depth 34 feet. Type drilled
(Dug or drilled)

diameter 12 inches. Elevation of ground at well site _____ feet, mean sea level.
(As near as known)

Depth to water table 14 feet.

7. Capacity of Well: 1350 g.p.m. with 8 feet drawdown.
_____ g.p.m. with _____ feet drawdown.

Date of test Dec 1948

If Flowing Well: Measured discharge _____ g.p.m. on _____
(Date)

Shut-in pressure at ground surface _____ lbs. per sq. in. on _____
(Date)

Water is controlled by _____
(Cap, valve, etc.)

If log of well is not available, give name and address of driller. A. Sloper

Independence, Ore

11. Infiltration Trench: Covered or open

Dimensions: Length ft. Minimum depth ft. Maximum depth ft.

Bottom width ft. Discharge g.p.m. Date of test

12. Tunnel: Type of lining

Dimensions:
(Length, course, and cross sectional size)

Position of water bearing stratum with reference to portal of tunnel

Log of tunnel: (Preceding table for log of well may be used, if desired. Give footage from portal and character of materials, as pertinent.)

13. Pumping Equipment:

(a) Pump Fairbank Morse 5" split case Capacity 1500 g.p.m.
(Make, type and size)

(b) Motor 75 HP Electric or 100 HP diesel
(Type and horsepower)

14. Location of area irrigated or to be irrigated, or place of use if for purposes other than irrigation.


Township North or South	Range E or W of Williamsite Meridian	Section	Forty-acre Tract	Number Acres To Be Irrigated	Date of Reclamation
85	R4W	27	NW 1/4 SW 1/4	2.8	1948
✓	✓	✓	NE 1/4 SW 1/4	17.0	"
✓	✓	✓	NW 1/4 SE 1/4	33.4	"
✓	✓	✓	SW 1/4 SE 1/4	21.5	"
✓	✓	✓	NE 1/4 SE 1/4	2.0	"
				<u>80.7</u>	

This farm owns and operates several pumps of various capacities depending on water needs in various fields or crops. Any one of 6 different pumps listed below may be in this well.

1	100 HP	Fairbanks diesel	Powered	5" pump	
2	75	Electric			
3	40 HP				
4	15 HP			3"	
5	15 HP	Pacific			
6	50 HP	Fairbanks diesel			

15. If the ground water supply is supplemental to an existing water supply, identification of any application for a permit, permit, certificate or adjudicated right to appropriate water made or held by the registrant.

Township 8S Range 4W, W.M.
North

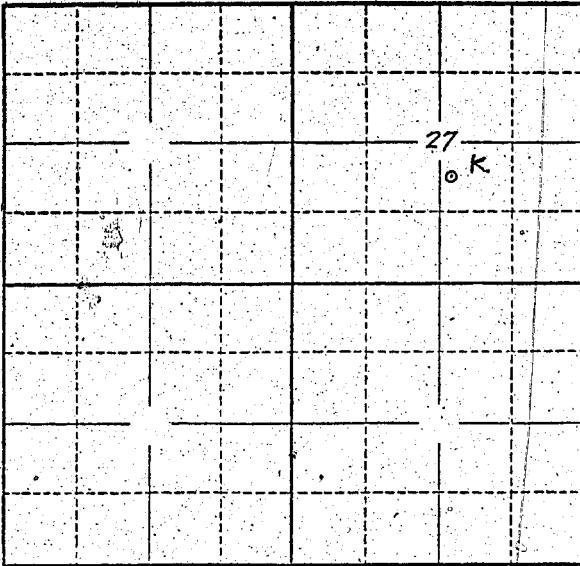

Locate well and acreage of irrigated land on plat.
Scale: 2" = 1 Mile

STATE OF OREGON

County of Marion } ss.

I, Eugene D. MacCarthy, being first duly sworn, do hereby certify that I have read the foregoing Registration Statement and that all of the items therein contained are true to the best of my knowledge and belief.

Eugene D. MacCarthy
(Signature of Registrant)

Subscribed and sworn to before me this 22 day of July, 1958.

My commission expires 9/27/58

Jeanie Baxter
(Notary Public)

(SEAL)

CERTIFICATE OF REGISTRATION

STATE OF OREGON } ss.
County of Marion

This is to certify that the foregoing Registration Statement was received in the office of the State Engineer on the 22nd day of July, 1958, at 9:00 o'clock A.M. and has been duly recorded in said office in Book No. 10 of Registration Statements on page GR-2352

Witness my hand this 10th day of March

Lewis A. Stanley
(State Engineer)

22.65

By _____
(Deputy)